



FORM F-106




00269886

RECEIVED

OCT 19 1973

COLC. OIL & GAS COM. OMM.

R. 53W

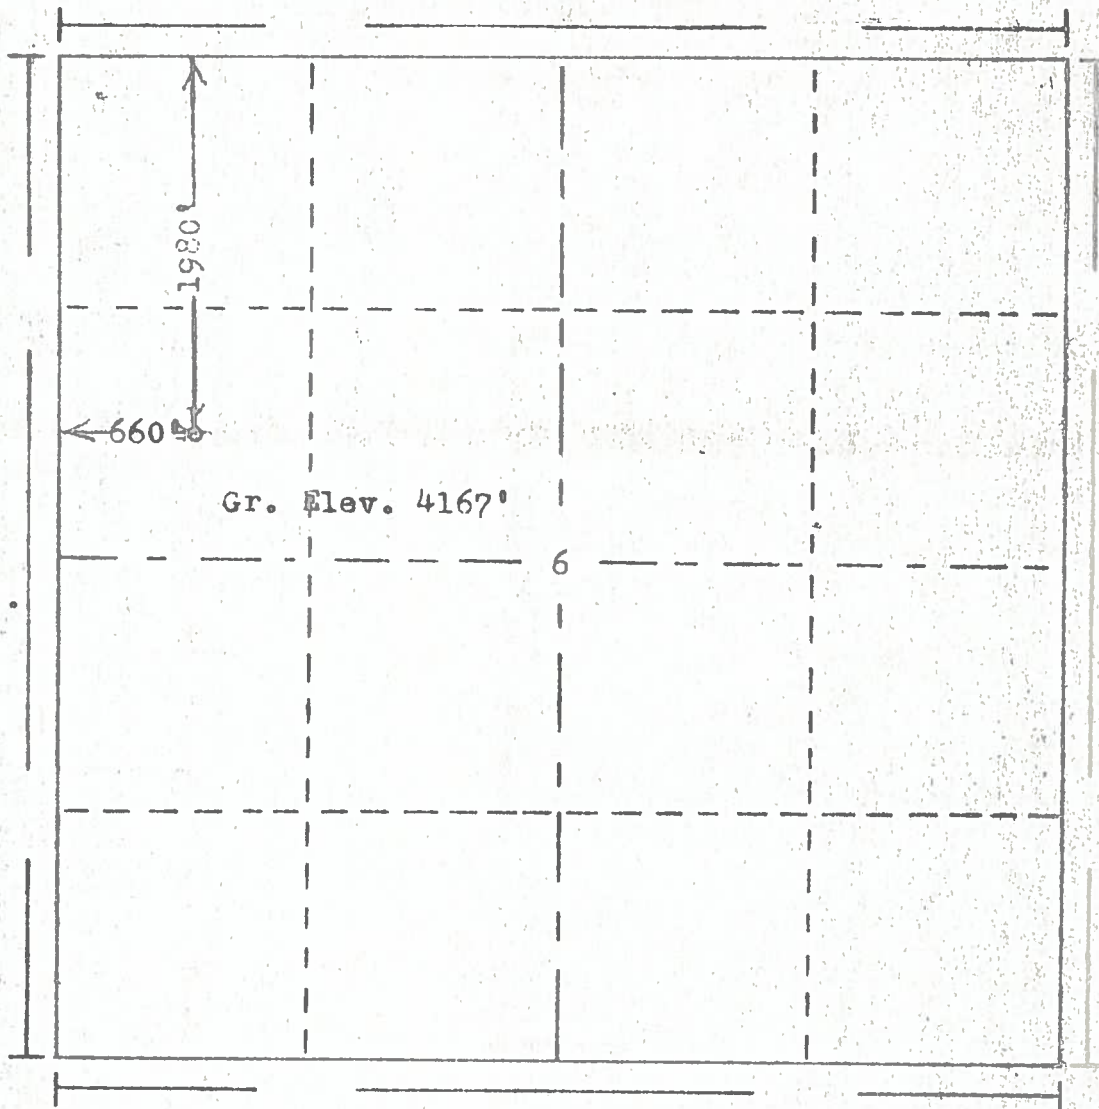

T. 9 N

Scale... 1" = 1000'

Powers Elevation Company, Inc. of Denver, Colorado
has in accordance with a request from Mr. Gear
for Donald C. Winslow et al

determined the location of No. 1 Cedar Creek Ranch
to be CSW NW

Section 6 Township 9N
Range 53W of the 6th Principal Meridian
Logan County, Colorado

I hereby certify that this plat is an
accurate representation of a correct
survey showing the location of

Date: 10-10-78

Robert J. Hall
Licensed Land Surveyor No. 2853
State of Colorado