



# FRANE SURVEYING INC.


Physical Address: 34834 Annie Cir.  
Mail to: Box 2372, Elizabeth, CO 80107  
Ph. 303-243-0037  
www.franesurveying.com  
Job # 19-136 WHP MISTY 2-7

Frane Surveying of Elizabeth, Colorado, has in accordance with a request from **Koda Exploration LLC**, has determined the location of **WHP Misty 2-7** to be **952 feet FNL**, and **2074 feet FEL**, of **SECTION 7**, Township **17s**, Range **54w** of the 6th Principal Meridian, **Lincoln County**, Colorado.

**Date:** Staked on 07/15/19 drawn on 07/31/19.  
**Rev:** 05/06/2020

**Re:** Staked by Elijah Frane  
**Drawn:** Drawn by Elijah Frane

## Access Road Map

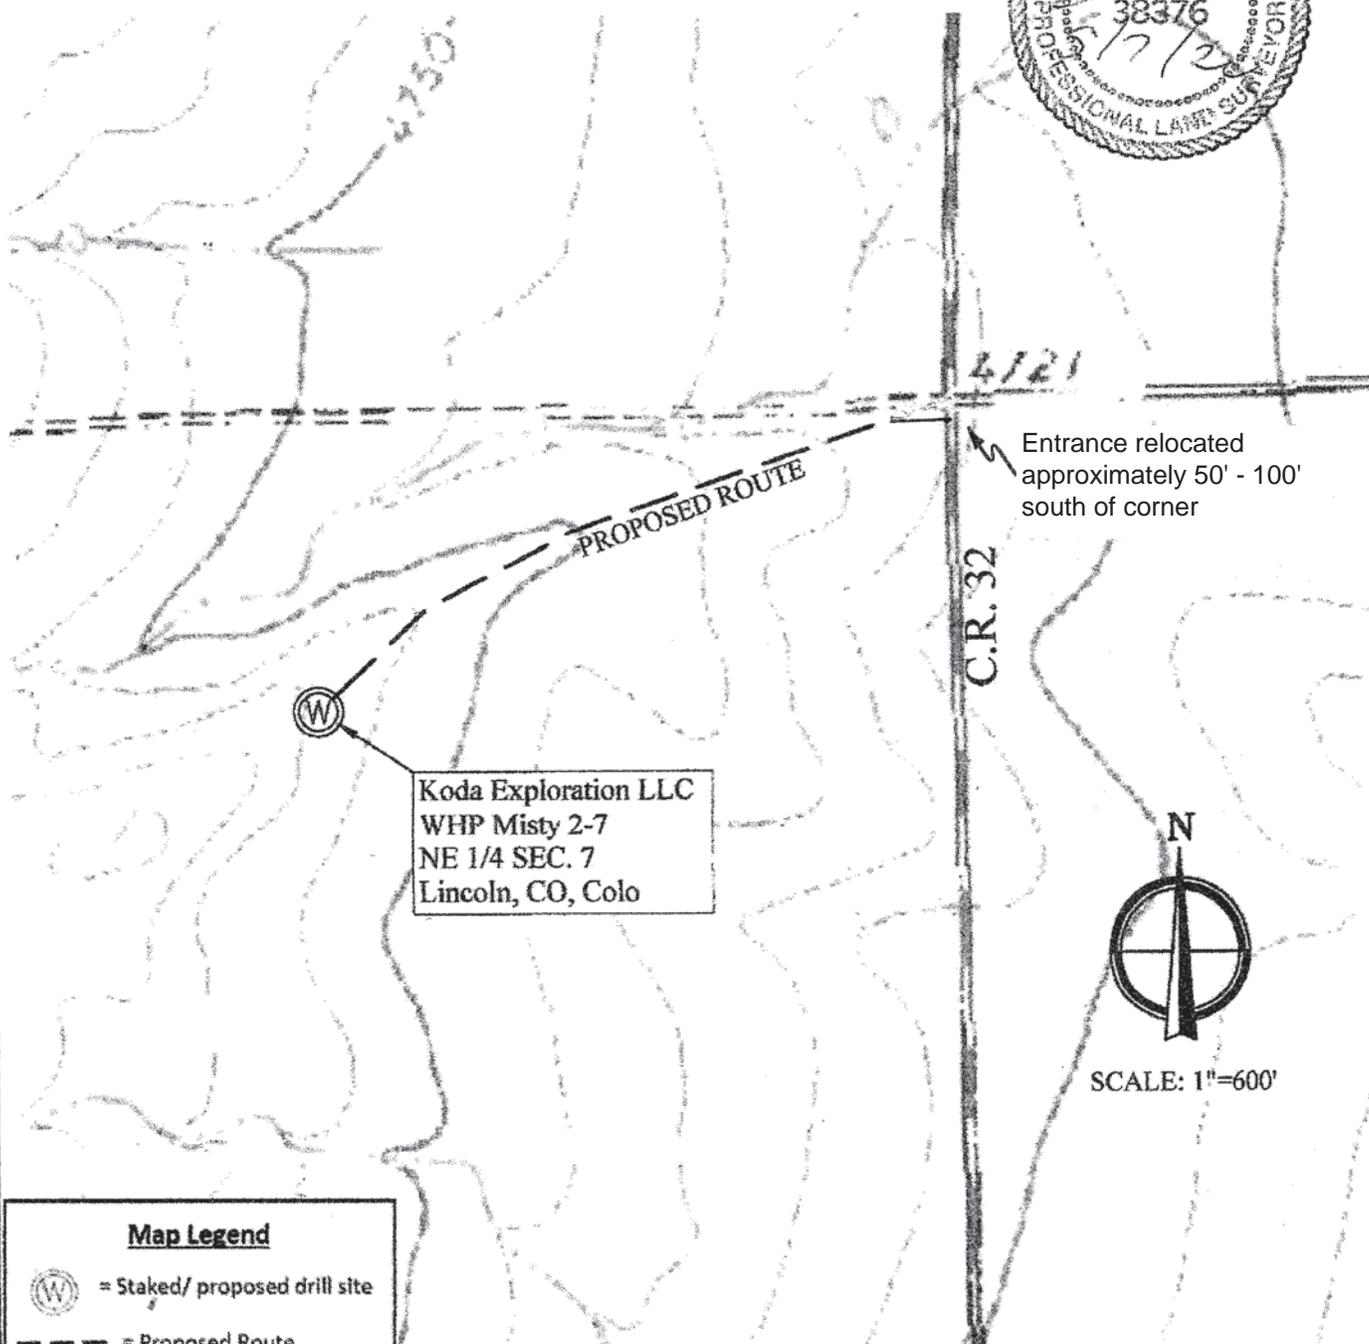

Koda Exploration LLC  
WHP Misty 2-7  
NE 1/4 SEC. 7  
Lincoln, CO, Colo



SCALE: 1"=600'

### Map Legend

- = Staked/ proposed drill site
- = Proposed Route