


Well Name: KORI J19-15

VERTICAL, ORIGINAL HOLE, 10/23/2020 7:18:52 AM

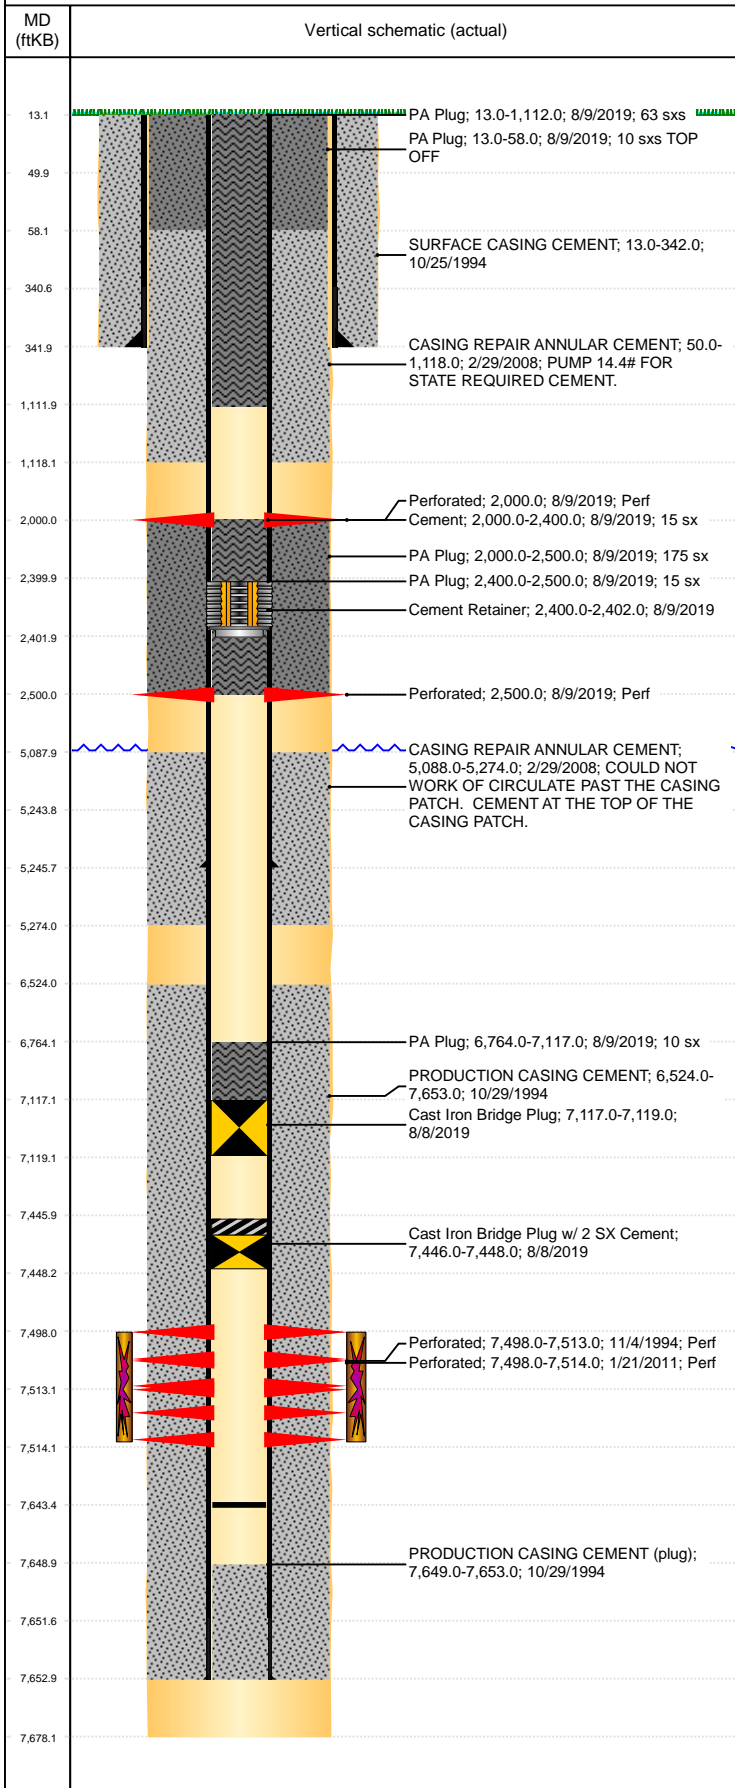

Well Header									
API 05-123-16363		Business Unit DJ BASIN			District 15		Well Config VERTICAL		
KB - GL / MSL (ft... 13.00		Spud Date 10/25/1994		P & A Date 3/26/2020		Well Production Status PA			SoRT No
Comment FRAC'D INTO 10/02 by J19-10; CSG REPAIR 2008									
Surface Location (Congressional)									
Qtr 3 SW	Qtr 4 SE	Section 19	Twnshp 5	Twنش... N	Range 66	Rng E/... W	Actual Latitude (°) 40.37950843		Actual Longitude (°) -104.82006507
Wellbore Sections									
Section Des			Size (in)			Act Top, MD (ftKB)		Act Btm, MD (ftKB)	
SURFACE			12 1/4			13		342	
PRODUCTION			7 7/8			342		7,678	
Casing Strings									
Csg Des			Run Date		OD (in)	Wt/Len (lb/ft)	Grade	Top, MD (ftKB)	MD (ftKB)
Surface Casing			10/25/1994		8 5/8	24.00		13.0	342.0
Production			2/26/2008		2 7/8	6.50	N-80	13.0	5,245.7
Production			10/29/1994		2 7/8	6.50	N-80	13.0	7,653.0
Cement									
Des					Start Date		Top (ftKB)		Btm (ftKB)
SURFACE CASING CEMENT					10/25/1994		13.0		342.0
PRODUCTION CASING CEMENT					10/29/1994		6,524.0		7,653.0
CASING REPAIR ANNULAR CEMENT					2/29/2008		50.0		1,118.0
CASING REPAIR ANNULAR CEMENT					2/29/2008		5,088.0		5,274.0
PA Plug					8/9/2019		6,764.0		7,117.0
					8/9/2019		2,000.0		2,400.0
PA Plug					8/9/2019		2,400.0		2,500.0
PA Plug					8/9/2019		2,000.0		2,500.0
PA Plug					8/9/2019		13.0		1,112.0
PA Plug					8/9/2019		13.0		58.0
Zone Statuses									
Zone Name		Status Date		Status	Fluid Type	Job			Prod Method
CODELL		3/21/2011		PR		RE-FRAC, 1/19/2011 12:00			
CODELL		9/22/2016		SI					
Perforation Data									
Linked Zone			Bnch/Stg	Entered Shot Total	Top (ftKB)		Btm (ftKB)		Date
				4	2,000.00		2,000.00		8/9/2019
				6	2,500.00		2,500.00		8/9/2019
CODELL, ORIGINAL HOLE				64	7,498.00		7,514.00		1/21/2011
CODELL, ORIGINAL HOLE				46	7,498.00		7,513.00		11/4/1994
Stimulation Intervals									
Zone				Start Date		Top (ftKB)		Btm (ftKB)	
CODELL, ORIGINAL HOLE				1/31/2011		7,498.0		7,514.0	
CODELL, ORIGINAL HOLE				11/8/1994					
Other In Hole									
Run Date		Des			Make		OD (in)	Top (ftKB)	Btm (ftKB)
8/8/2019		Cast Iron Bridge Plug w/ 2 SX Cement					2.44	7,446.0	7,448.0
8/8/2019		Cast Iron Bridge Plug					2.44	7,117.0	7,119.0
8/9/2019		Cement Retainer					2.44	2,400.0	2,402.0
Logs									
Date		Type					Top, MD (ftKB)		Btm, MD (ftKB)
10/28/1994		Compensated Density					6,700.0		7,690.0
10/28/1994		Induction					6,700.0		7,690.0
11/4/1994		CBL/CCL/GR					6,350.0		7,621.0
2/3/2008		CBL/CCL/GR					13.0		5,418.0
12/1/2017		GYRO					12.0		7,400.0
Plug Back Total Depths									
Date		Type			Com				Depth (ftKB)
3/3/2008		FILL			PULL RBP TO RETURN TO PRODUCTION.				7,642.8
2/7/2011		FILL			FILL - TBG TALLY				7,643.3