


Well Name: WILMOTH C 4-23

VERTICAL, ORIGINAL HOLE, 6/15/2020 12:28:05 PM

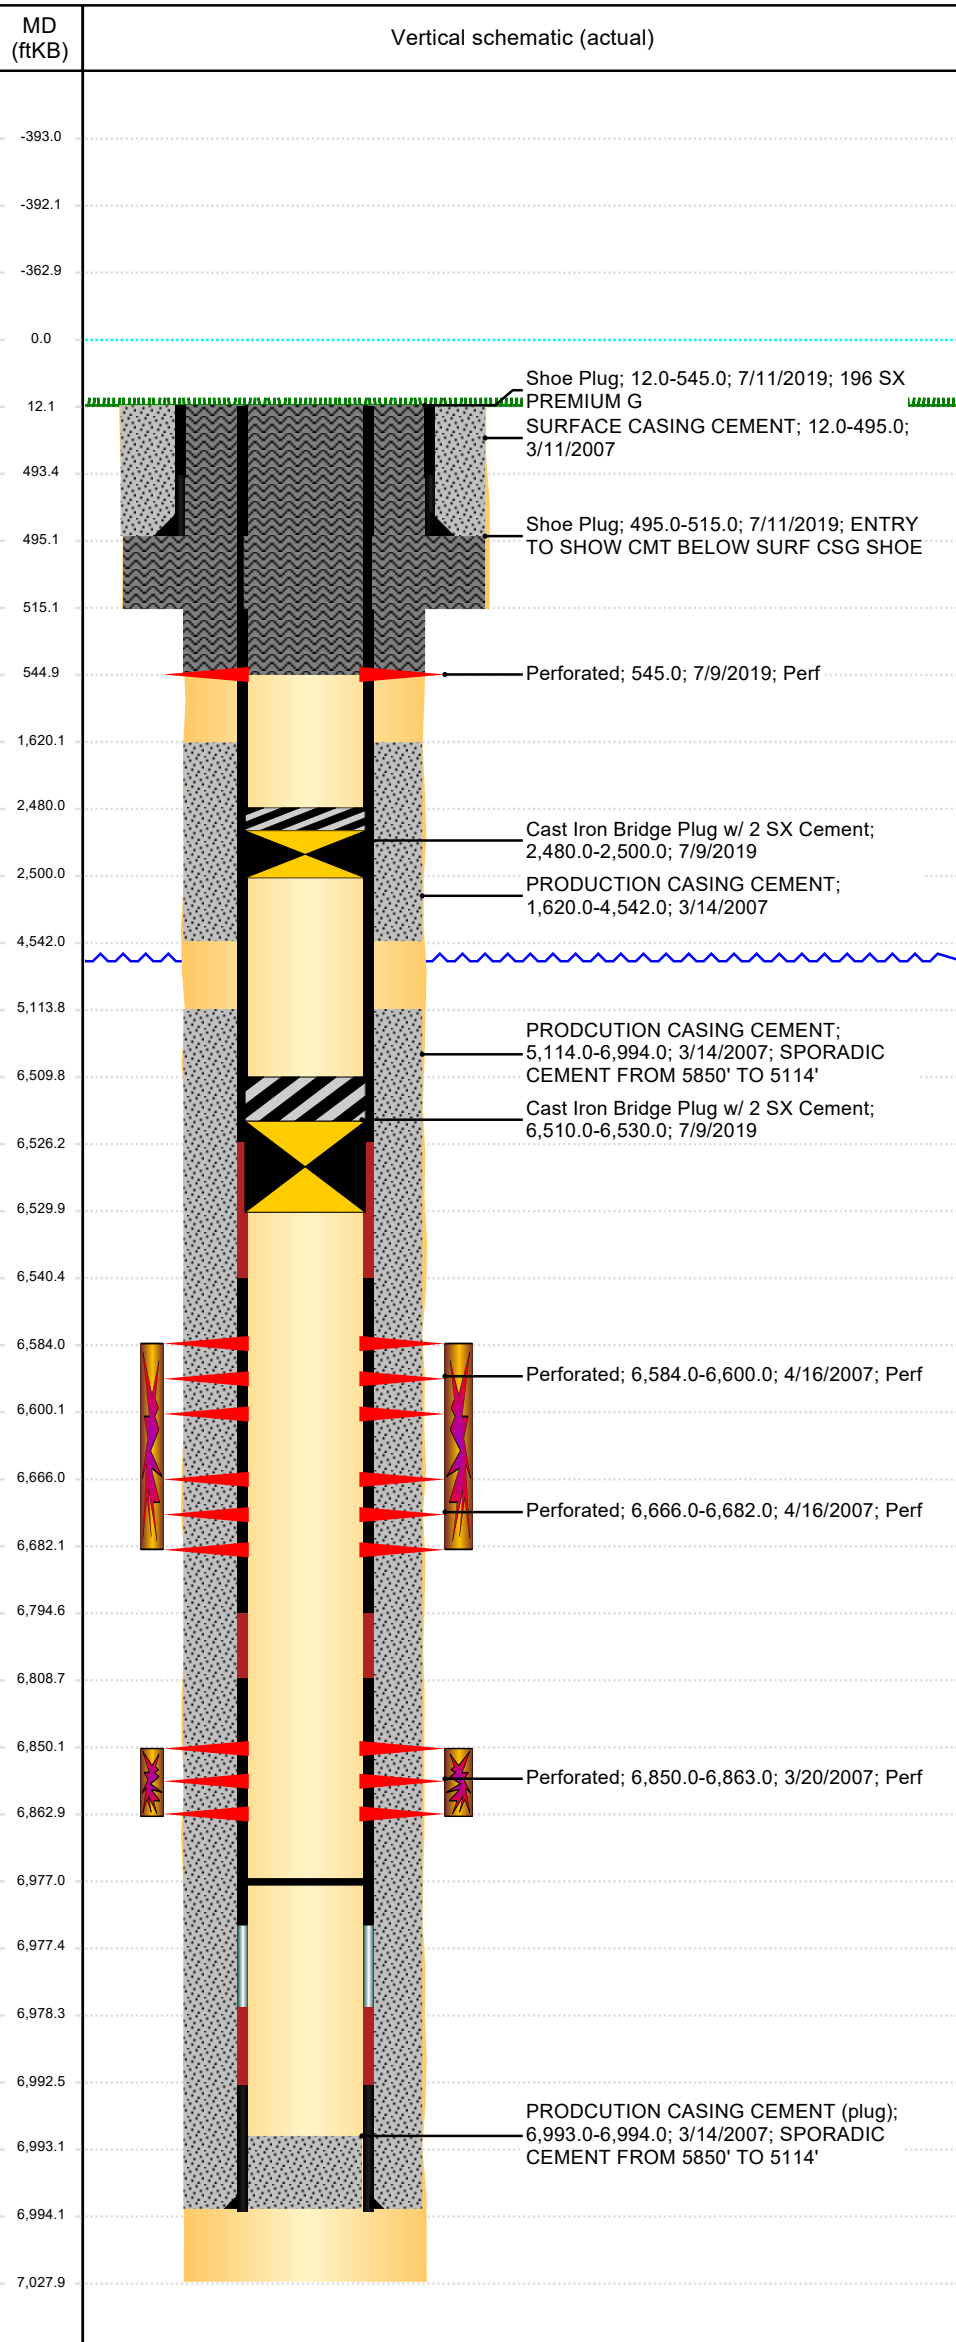

Well Header									
API 05-123-24525		Business Unit DJ BASIN			District 15		Well Configuration Type VERTICAL		
KB - GL / MSL (ftKB) 12.00		Spud Date 3/10/2007		P & A Date 9/17/2019		Well Production Status PA			SoRT Yes
Comment									
Surface Location (Congressional)									
Quarter 3 SE	Quarter 4 SE	Section 4	Township 4	Twnshp N N	Range 64	Rng E/W W	Actual Latitude (°) 40.33773555	Actual Longitude (°) -104.55034670	
Wellbore Sections									
Section Des			Size (in)			Act Top, MD (ftKB)		Act Btm, MD (ftKB)	
SURFACE			12 1/4			12		515	
PRODUCTION			7 7/8			515		7,028	
Casing Strings									
Csg Des			Run Date		OD (in)	Wt/Len (lb/ft)	Grade	Top, MD (ftKB)	MD (ftKB)
Surface			3/11/2007		8 5/8	24.00	J-55	12.0	495.0
Production			3/13/2007		4 1/2	11.60	M-80	12.0	6,994.0
Cement									
Des					Start Date		Top (ftKB)		Btm (ftKB)
SURFACE CASING CEMENT					3/11/2007		12.0		495.0
PRODUCTION CASING CEMENT					3/14/2007		1,620.0		4,542.0
PRODCUTION CASING CEMENT					3/14/2007		5,114.0		6,994.0
Shoe Plug					7/11/2019		12.0		545.0
Shoe Plug					7/11/2019		495.0		515.0
Zone Statuses									
Zone Name	Status Date	Status	Fluid Type	Job				Prod Method	
CODELL	5/10/2007	PR		DRILLING/COMPLETION - ORIGINAL, 3/10/2007 00:00				Flowing	
CODELL	7/9/2019	P&A		PLUG AND ABANDON, 7/8/2019 06:30					
NIOBRARA	4/18/2007	PR		DRILLING/COMPLETION - ORIGINAL, 3/10/2007 00:00					
NIOBRARA	7/9/2019	P&A		PLUG AND ABANDON, 7/8/2019 06:30					
Perforation Data									
Linked Zone		Bnch/Stg	Entered Shot Total	Top (ftKB)		Btm (ftKB)		Date	
			6	545.00		545.00		7/9/2019	
NIOBRARA, ORIGINAL HOLE			64	6,584.00		6,600.00		4/16/2007	
NIOBRARA, ORIGINAL HOLE			64	6,666.00		6,682.00		4/16/2007	
CODELL, ORIGINAL HOLE			52	6,850.00		6,863.00		3/20/2007	
Stimulation Intervals									
Zone			Start Date		Top (ftKB)		Btm (ftKB)		
NIOBRARA, ORIGINAL HOLE			4/16/2007		6,584.0		6,682.0		
CODELL, ORIGINAL HOLE			4/16/2007		6,850.0		6,863.0		
Other In Hole									
Run Date	Des				Make	OD (in)	Top (ftKB)	Btm (ftKB)	
10/14/2017	Plunger Lift					1 7/8			
7/9/2019	Cast Iron Bridge Plug w/ 2 SX Cement					4	6,510.0	6,530.0	
7/9/2019	Cast Iron Bridge Plug w/ 2 SX Cement					4	2,480.0	2,500.0	
Logs									
Date		Type				Top, MD (ftKB)		Btm, MD (ftKB)	
3/13/2007		COMPENSATED DENSITY				2,650.0		7,012.0	
3/13/2007		INDUCTION				495.0		7,032.0	
3/20/2007		CEMENT BOND				1,450.0		6,988.0	
2/22/2017		GYRO				0.0		6,800.0	
Plug Back Total Depths									
Date		Type		Com				Depth (ftKB)	
3/20/2007		FILL		DEPTH LOGGER ON CBL				6,993.0	
5/10/2007		FILL		CLEAN OUT CFP				6,977.0	