


NICKEL ROAD OPERATING

BASIS OF ELEVATION
OPUS SOLUTION GENERATED NAVD 88

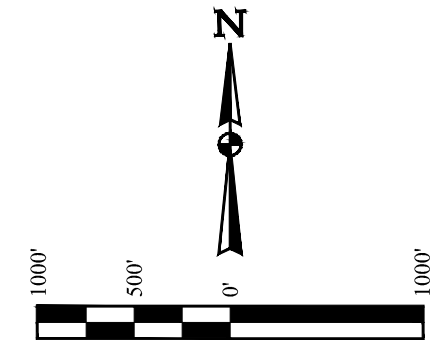

RTIFICATE
ABOVE MAP WAS PREPARED FROM FIELD
MADE MEASUREMENTS UNDER MY SUPERVISION
AND CONFORMS TO THE BEST OF MY
KNOWLEDGE

[Signature]

REGISTERED LAND SURVEYOR
REGISTRATION NO. 28285

88-06-20

PDOP = 1.9

REV: 1 08-03-20 C.IVIE (UPDATE ELEVATION NOTE)



UINTECH
ENGINEERING & LAND SURVEYING

UELS, LLC
Corporate Office * 85 South 200 East
Vernal, UT 84078 * (435) 789-1017

SURVEYED BY	NATE WELCH, A.S.	06-23-20	SCALE
DRAWN BY	Z.L.	07-23-20	1" = 1000'

WELL LOCATION PLAT