



WELLBORE DIAGRAM
FINAL WBD

1980 FSL 1980 FWL

1 Mile Offset:
No PR Sussex
Deepest WW: 200'
No fox hills aquifer data
Upper Pierre Base @ 1115'
Topped off w/ 20 sx Class G+2%CC


Pump from 626' to surface
w/ 280 sx Class G w/ 2%CaCl2

Tagged plug @ 626'
Pump from 998' to calc TOC @ 400'
w/ 230 sx Class G w/ 2%CaCl2

Tagged plug at 998'
Pump from 1545' to calc TOC @ 525'
w/ 300 sx Class G w/2%CaCl2

Tagged plug at 1577'
Pump 200 sx Class G w/ 2%CC
from 2577' to calc TOC @ 1897'

Cut and Cap (Well Name,
API, Legal Desc.)
10' below proposed grade
Cut & capped on 10/30/2020

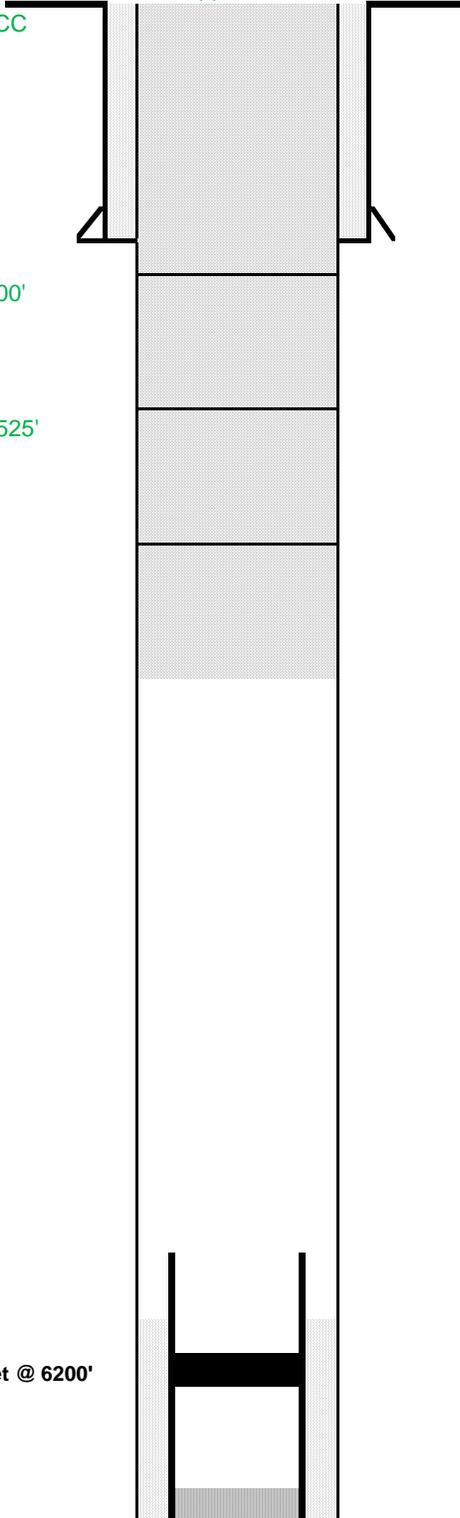

Operator: Walter Properties
Well Name: Thayer 2-30
Lease Number:
Location: NESW 30 6N 67W
Field: Mako - #52420
County, State: Weld CO
API Number: 05-123-12031
Diagram Date: 11/23/2020
Lat/Long: 40.455913/-104.936947

KB

GL 4955'

Spud Date: 10/28/1984

Surface Casing : 13-1/4" hole

9-5/8" 24# set @ 533'

Cmt w/ 300 sx Class G w/ 3% CaCl2

Production Casing : 7-7/8" hole

5-1/2" 20# set @ 7900'

Cmt w/ 390 sx Class G w/ 10% salt

Tubing Detail:

Formation Tops:

Pierre	2355'
Parkman	3550'
Sussex	4252'
Shannon	4638'
Niobrara	6961'
Fort Hays	7272'
Codell	7290'
J Sand	7765'

Perforations

J Sand:

Cut & pull casing @ 6061'

5-1/2" CIBP set @ 6200'
9/15/1987

MD = 7900'

PBMD =