API 0512346333	Occidental Petroleum Company	
	GEORGE 25-6HZ	

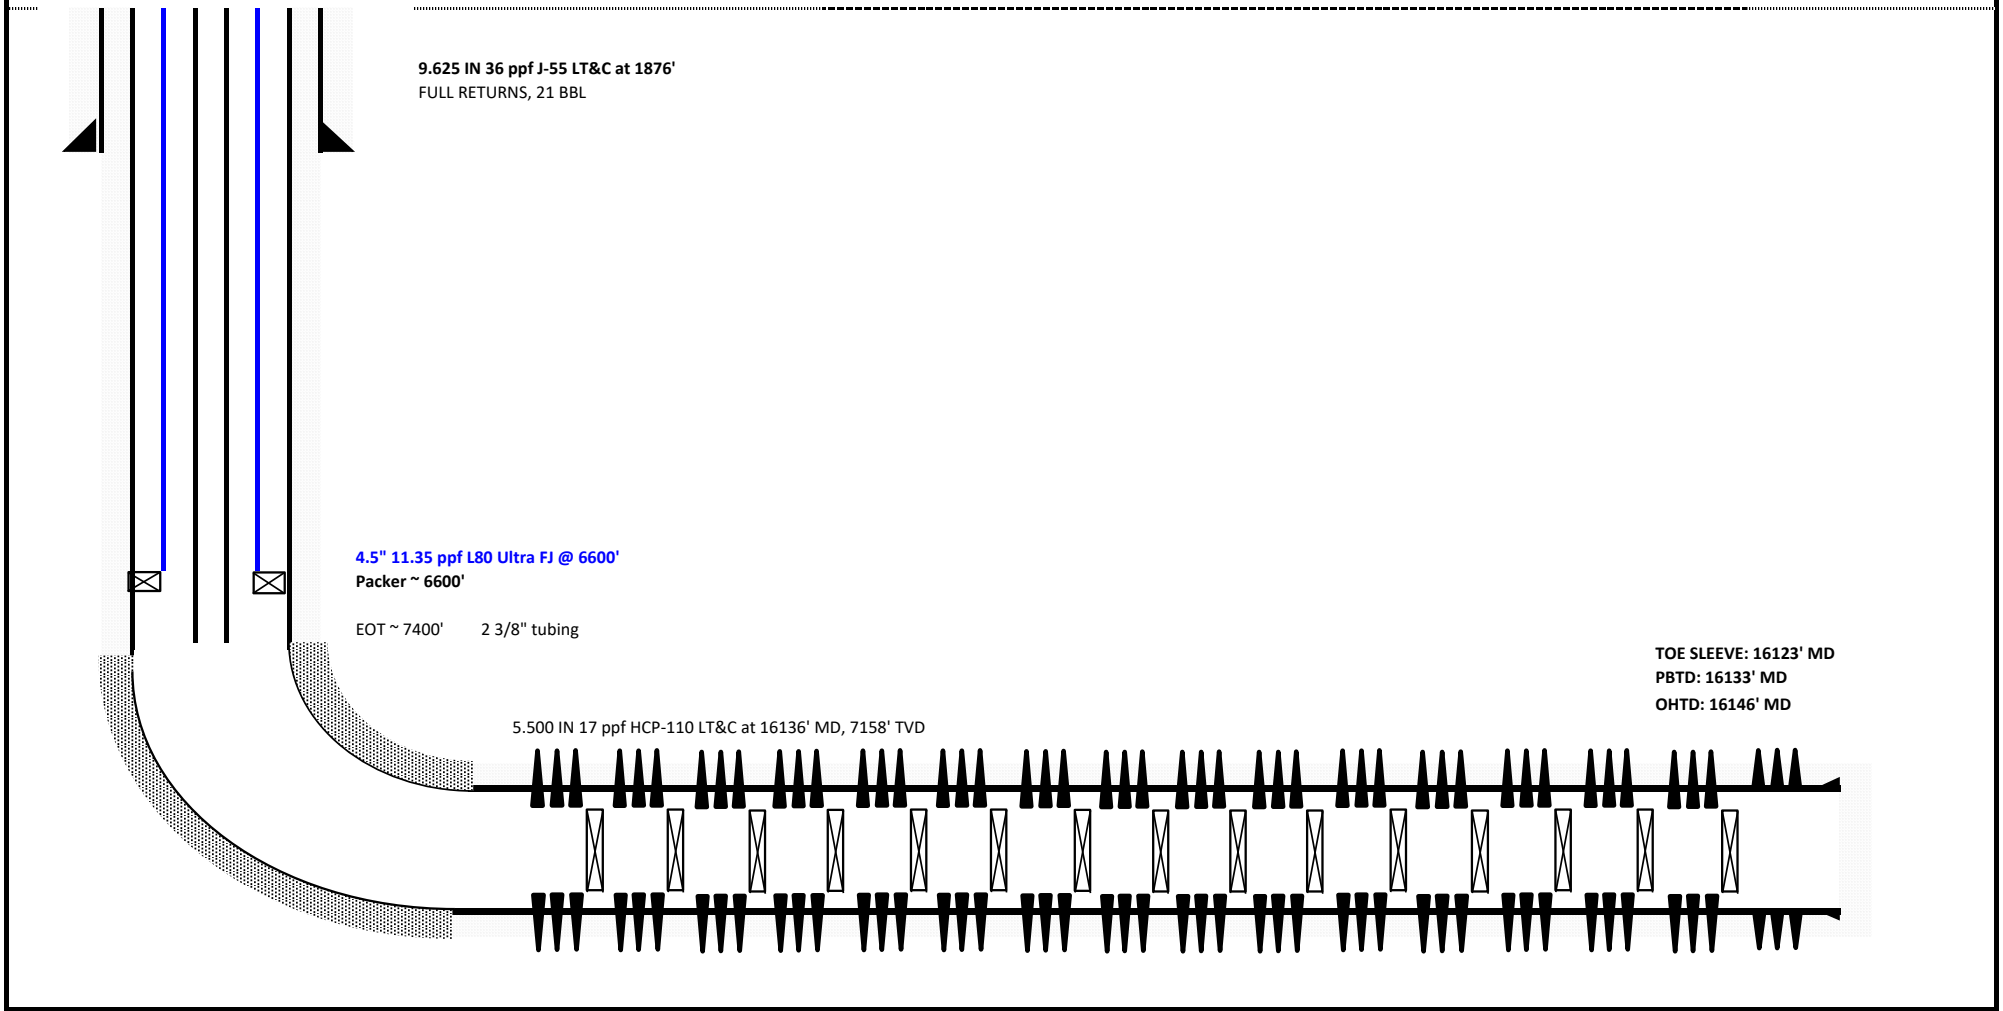

Surface Location: 2325/FNL 2045/FEL , T2N R65W Sec25 SWNE , WELD, CO
Lat: 40.110338 Long: -104.610032

WCR 16 & WCR 47 N 5/10, E 6/10 around field, E 300' into