SOIL SAMPLING LOCATION SCHEMATIC
UPDATED FROM INITIAL FORM 27 SUBMITTAL

FIGURE 2B : CUMMULATIVE EXCAVATION SOIL SAMPLING SCHEMATIC
BLUE CHIP GAIL #1 LOCATION
Facility ID 268645, COGCC Spill / ReleaseTracking # 402404592
SENW Section 18, Township 1S, Range 65W
SW 1/4 mile from intersection of 152nd (Bromley Lane) and Harvest Mill Road, Adams County

EXCAVATION CONFIRMATION SAMPLING

Sample #	Depth Ft. BGL	TPH GRO mg/kg	TPH DRO mg/kg	BTEX ug/kg	Sample Date
Soil-1	3-5'	ND	ND	ND	**Sept 21, 2020**
Soil-2	4-5'	92.0	21.0	B: ND T: 150 E: ND X: 1400	
Soil-3	5-6'	ND	ND	ND	
Soil-4	5-6'	2.1	11.0	ND	
Soil-5	5-6'	0.56	ND	ND	
Soil-6	4-5'	ND	ND	ND	
Soil-7	3-4'	ND	ND	ND	
Soil-8	3-4'	ND	ND	ND	**Sept 22, 2020**
Soil-9	4-5'	ND	ND	ND	
Soil-10	3-4'	ND	ND	ND	
Soil-11	5-6'	ND	ND	ND	
Soil-12	9-10'	ND	ND	ND	
Soil-13	Stk Pile South	ND	3.4	ND	
Soil-14	Stk Pile North	ND	3.6	ND	
Soil-15	4-5'	ND	80.0	ND	**July 29,2020**
Soil-16	6-7'	ND	14.0	ND	
Soil-17	6-7'	ND	34.0	ND	
Soil-18	6-7'	ND	6.1	ND	
Soil-19	6-7'	ND	18.0	ND	
PROBE SOIL SAMPLES					
Soil-PB1	6-8'	ND	5.9	ND	**Sept. 17, 2020**
Soil-PB2	6-8'	ND	5.1J	ND	
Soil-PB3	6-8'	ND	ND	ND	
Soil-PB4	6-8'	ND	5.1J	ND	
BACKGROUND SOIL SAMPLES					
PB2 BKG1	**2-4'**	**See Table 3 for Results**			
PB2 BKG2	**6-8'**	**See Table 3 for Results**			

*Lab results with detections, but below regulatory guidelines

See Table 1 for additional information.
mg/kg: milligram per kilopgrams

Approximate Soil Sample location
#8 Soil Sample ID: Soil 8
Probe / MW Location
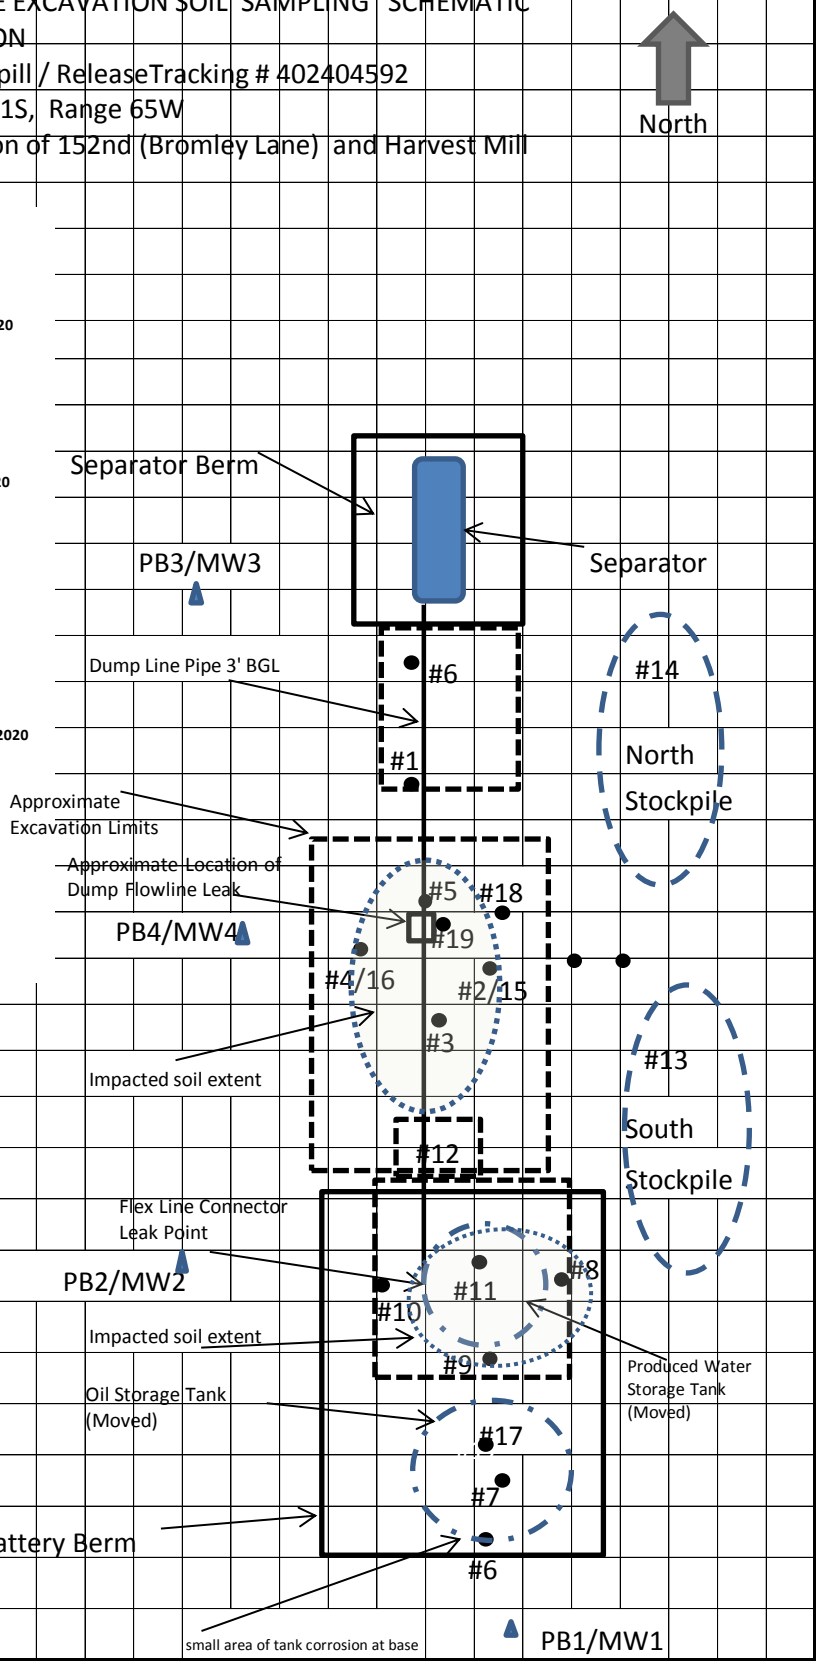
Scale 0 5 10 15 20 25 feet