

FIGURE 4: Gail #1 Tank Battery, Groundwater Depth Elevations

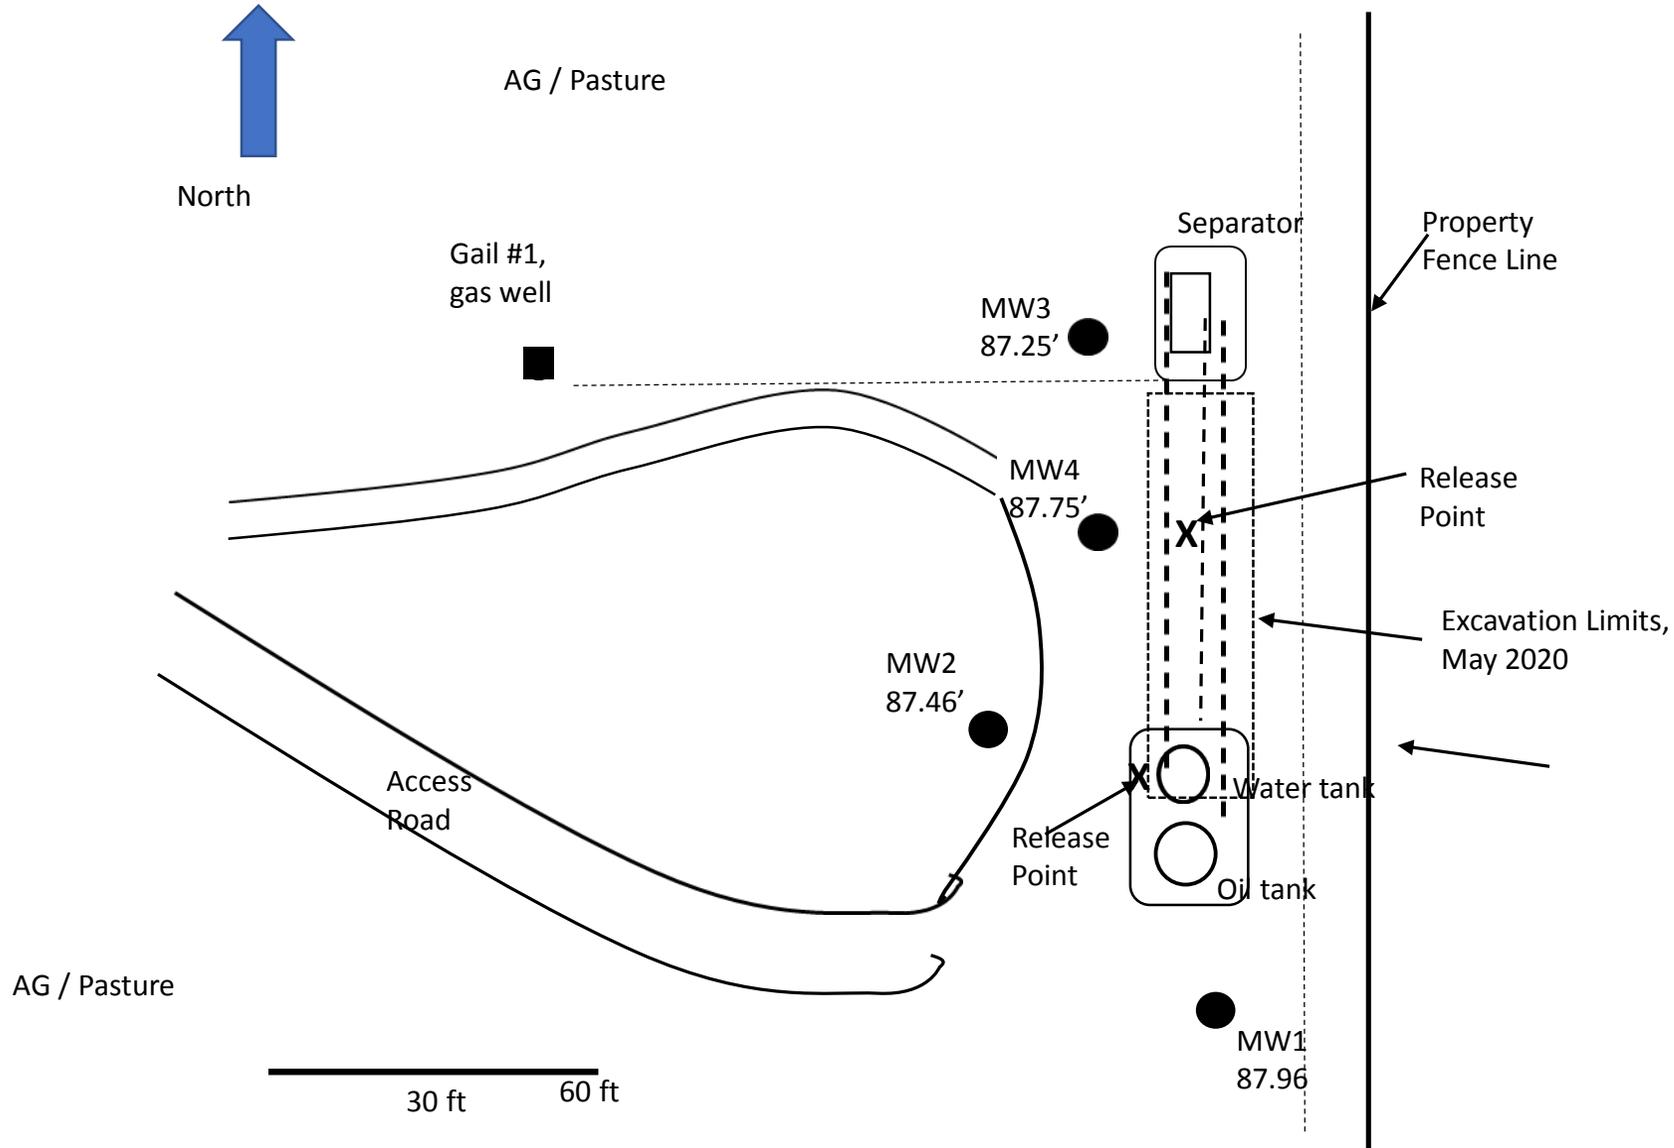


Figure 4 Groundwater Level Schematic
 Blue Chip Oil Inc, Gail #1 Tank Battery
 REMEDIATION PROJECT # 15735
 Facility ID 268645
 SENW Section 18, T 1S, R 65W
 Adams County

MW3 : Monitoring Well Location
 87.25': Relative Water Depth Elevation from
 a 100' Elevation Survey Control Point

Monitoring Wells
 Water Depth Measurements
 -Below Grade Level (BGL)

MW1: 7.8 ft
 MW2: 7.96 ft
 MW3: 7.8 ft
 MW4: 7.47 ft

AG / Pasture