




**WELLBORE DIAGRAM**  
CURRENT WBD

2020 FSL 850 FEL

1 Mile Offset:  
No PR Sussex  
Deepest WW: 980'  
Aquifer data is saved in wellfile

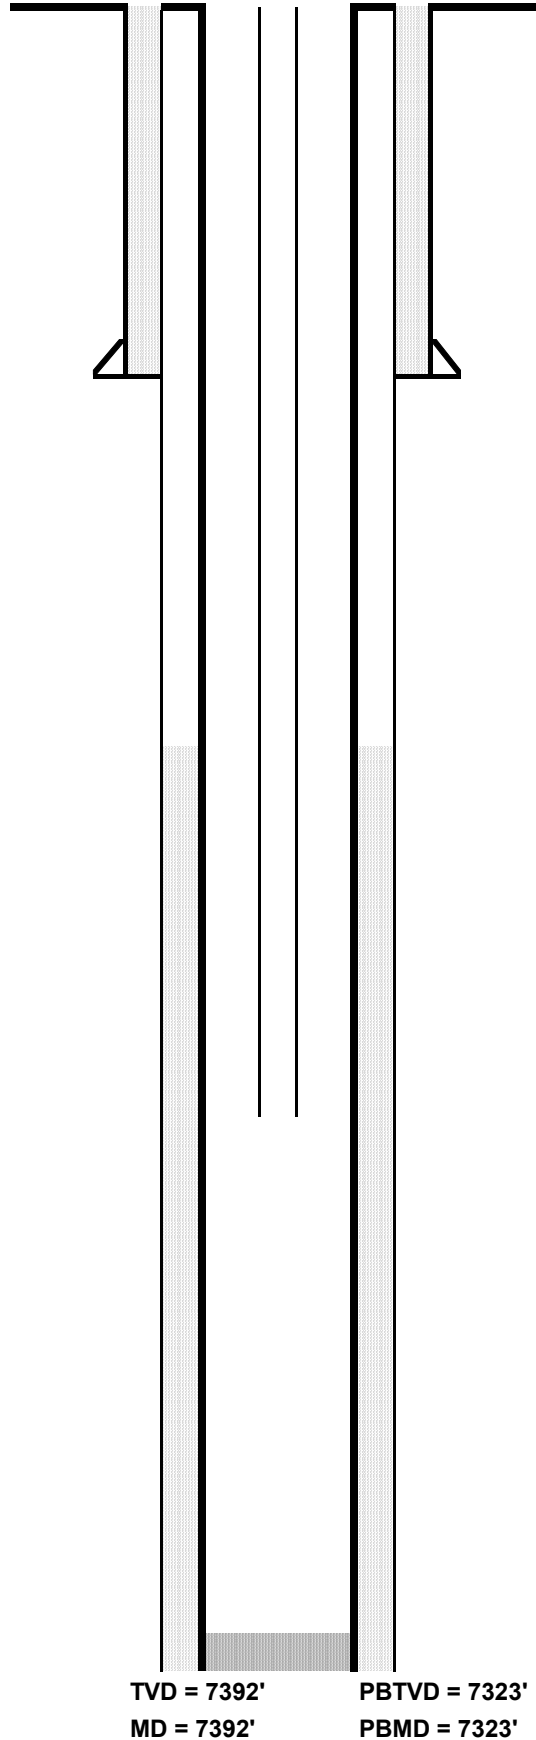

<b>Operator:</b>	Great Western Oil & Gas Company
<b>Well Name:</b>	Pearl Johnson 2
<b>Lease Number:</b>	
<b>Location:</b>	NESE Sec 8 T1N R63W
<b>Field:</b>	Scabbard - 766785
<b>County, State:</b>	Weld, Colorado
<b>API Number:</b>	05-123--23253
<b>Diagram Date:</b>	12/2/2020
<b>Lat/Long</b>	40.06439 / -104.45431

**KB** 4876'

**GL** 4856'

**Spud Date:** 10/8/2005

**Surface Casing :**

8-5/8" 24# 23 jnts set @ 931'

Cmt w/ 655 sx

**Production Casing :**

4-1/2", 11.6# 176 jnts set @ 7374'

Cmt'd w/ 200 sx

**Tubing Detail:**

2 3/8 - 231jts @ 7222'

12/21/2019

TOC @ 6400' CBL

**Formation Tops:**

Niobrara	6466'
Fort Hayes	6780'
D Sand	7198'
J Sand	7250'

**Perforations**

J-Sand 7260 - 7288'