


Confluence DJ LLC
Silverton 5-5-1L (fka Silverton 5-8-2L)
Drilled Formation: Niobrara
05-123-48440
NWSW 4-4N-63W
Weld County, CO



EXISTING WELLBORE DIAGRAM

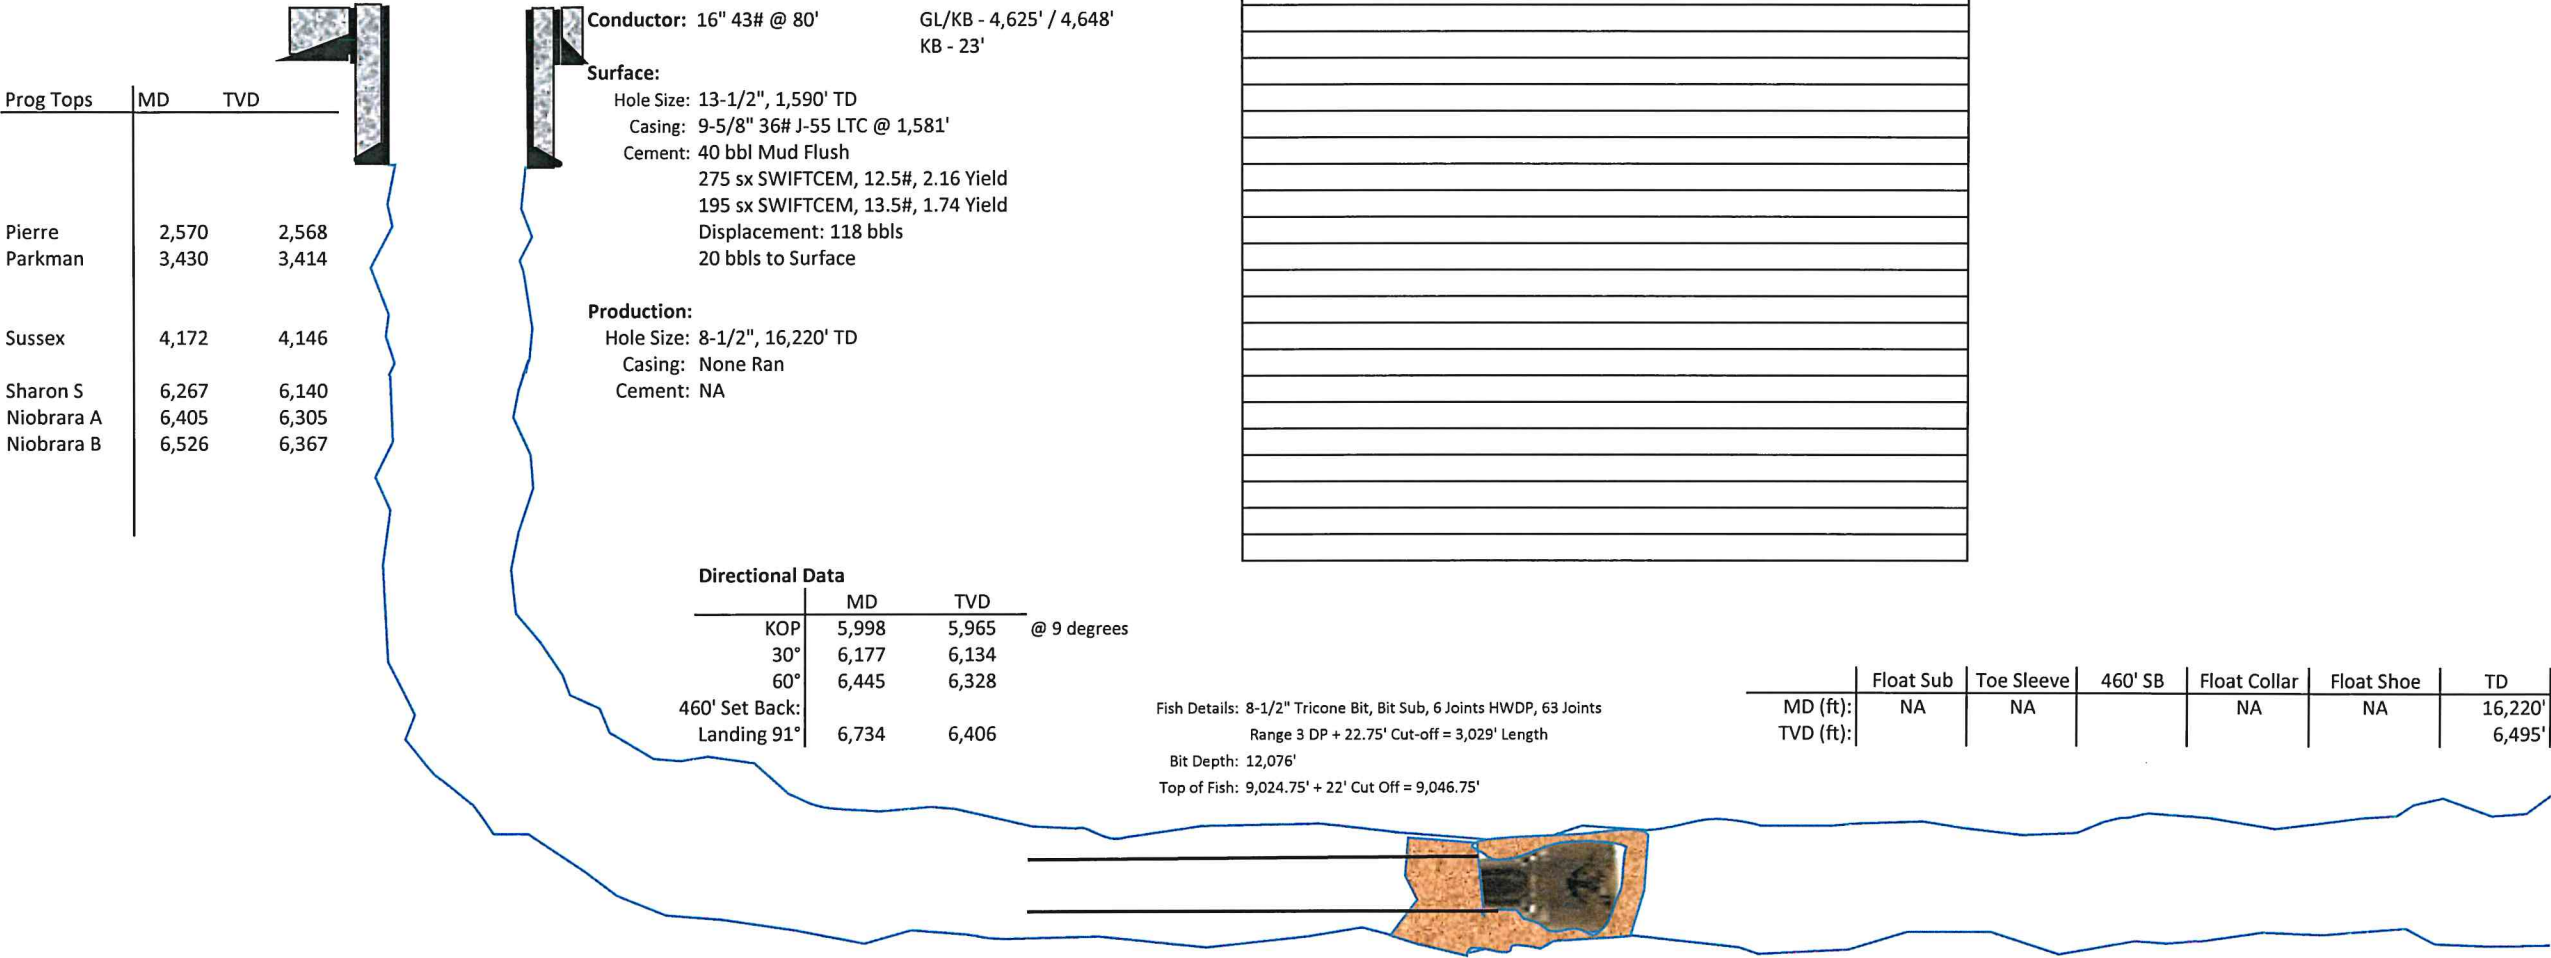

Weld County, CO



Directional Data			
	MD	TVD	
KOP	5,998	5,965	@ 9 degrees
30°	6,177	6,134	
60°	6,445	6,328	
460' Set Back:	6,720		
Landing 91°	6,734	6,406	

	Float Sub	Toe Sleeve	460' SB	Float Collar	Float Shoe	TD
MD (ft):	NA	NA	16,157'	NA	NA	16,220'
TVD (ft):						6,495'

S:\Confluence DJ\Well Files\1f - Silverton 5-5-1L\P&A\Silverton 5-5-1L Pre & Post P&A WBDs, 12-30-2020