


Well Name: DECHANT D30-20D

DEVIATED, ORIGINAL HOLE, 1/13/2021 9:38:11 AM

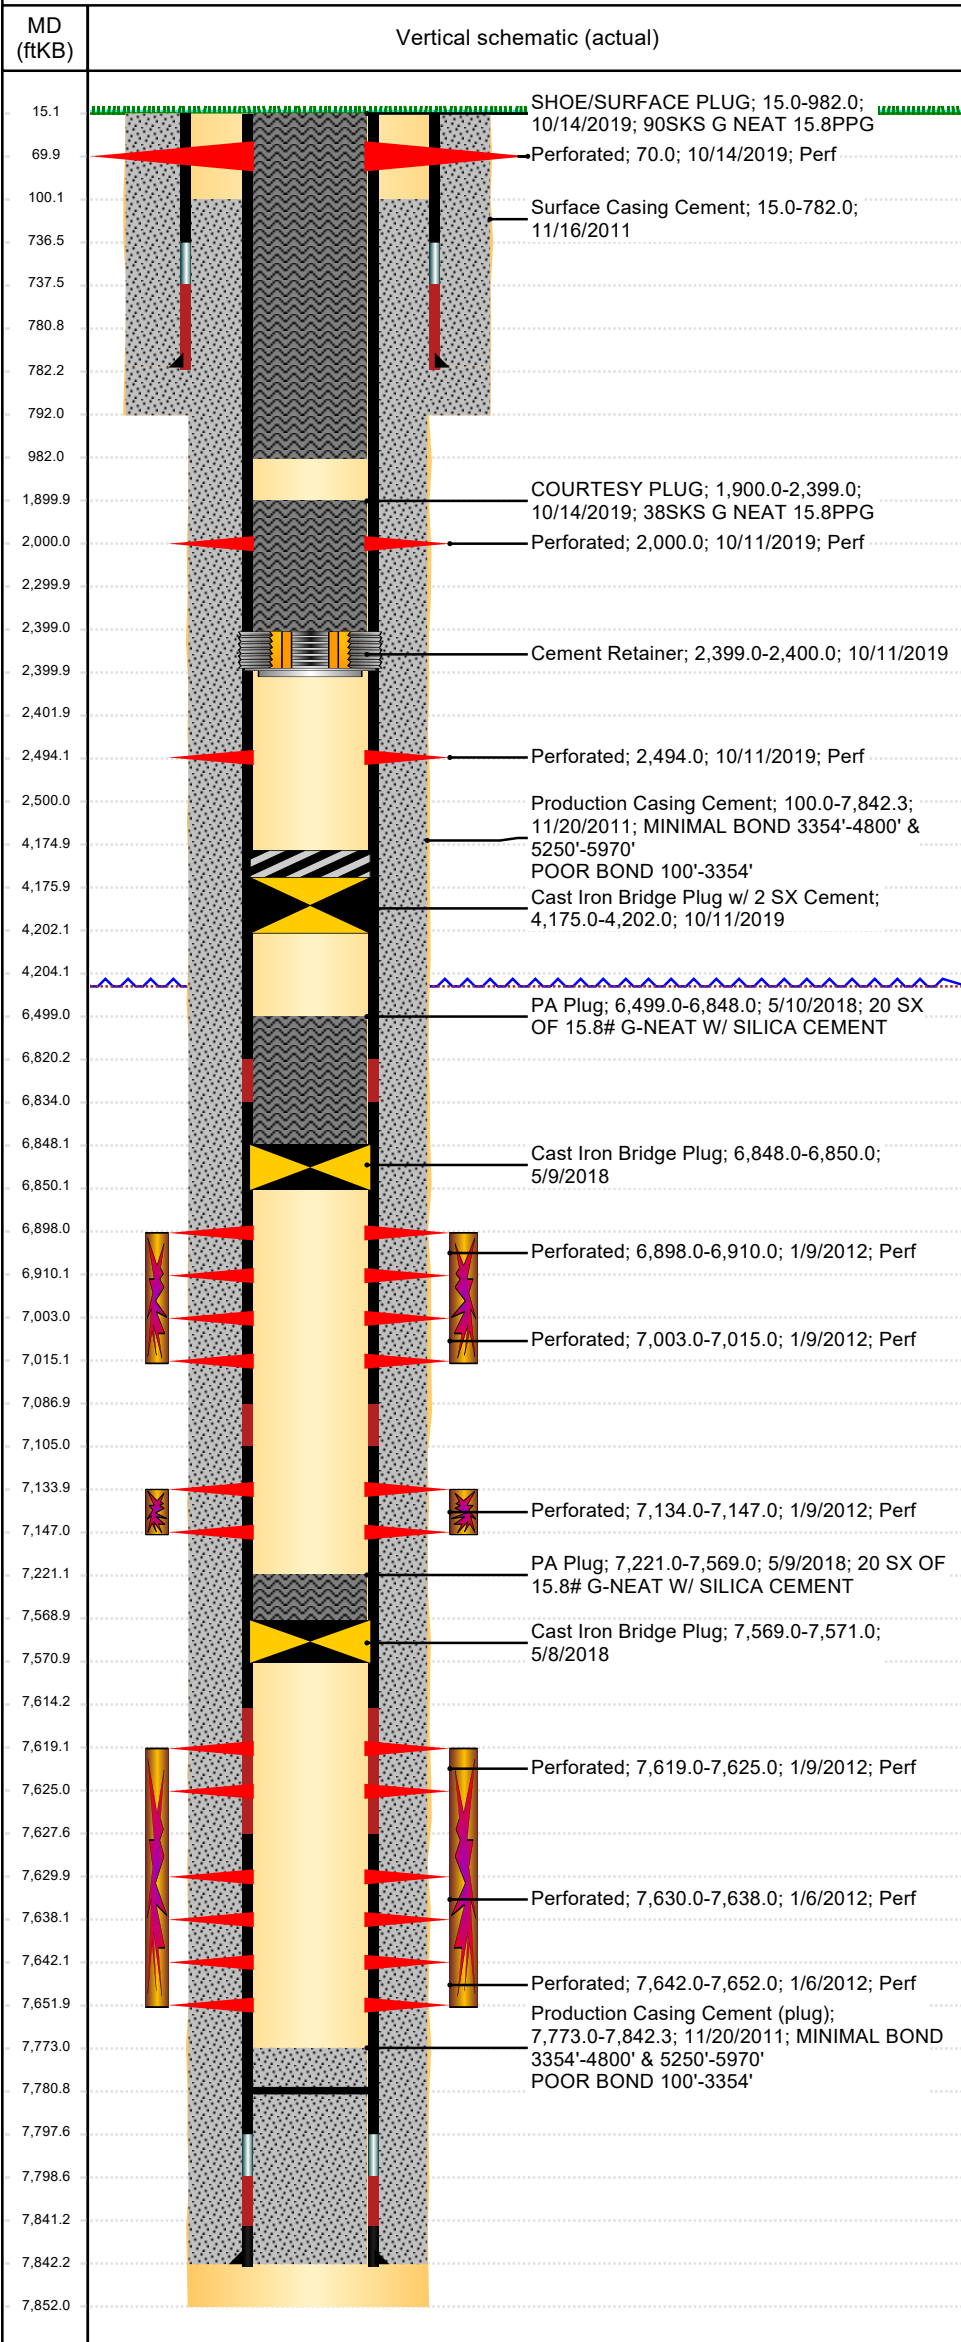

Well Header									
API 05-123-33002		Business Unit DJ BASIN			District 15		Well Configuration Type DEVIATED		
KB - GL / MSL (ftKB) 15.00		Spud Date 11/15/2011		P & A Date 12/21/2020		Well Production Status PA			SoRT Yes
Comment									
Surface Location (Congressional)									
Quarter 3 NW	Quarter 4 SW	Section 30	Township 3	Twnshp N N	Range 64	Rng E/W W	Actual Latitude (°) 40.19497973	Actual Longitude (°) -104.60077637	
Wellbore Sections									
Section Des			Size (in)			Act Top, MD (ftKB)		Act Btm, MD (ftKB)	
SURFACE			12 1/4			15		792	
PRODUCTION			7 7/8			792		7,852	
Casing Strings									
Csg Des			Run Date		OD (in)	Wt/Len (lb/ft)	Grade	Top, MD (ftKB)	MD (ftKB)
Surface			11/16/2011		8 5/8	24.00	J-55	15.0	782.0
PRODUCTION			11/20/2011		4 1/2	11.60	M-80	15.0	7,842.3
Cement									
Des					Start Date		Top (ftKB)		Btm (ftKB)
Surface Casing Cement					11/16/2011		15.0		782.0
Production Casing Cement					11/20/2011		100.0		7,842.3
PA Plug					5/9/2018		7,221.0		7,569.0
PA Plug					5/10/2018		6,499.0		6,848.0
COURTESY PLUG					10/14/2019		1,900.0		2,399.0
SHOE/SURFACE PLUG					10/14/2019		15.0		982.0
Zone Statuses									
Zone Name		Status Date	Status	Fluid Type	Job			Prod Method	
CODELL		5/10/2018	TA	Water	PLUG AND ABANDON, 5/8/2018 06:00				
CODELL		10/9/2019	P&A	Water	PLUG AND ABANDON, 5/8/2018 06:00				
NIOBRARA		5/10/2018	TA		PLUG AND ABANDON, 5/8/2018 06:00				
NIOBRARA		10/9/2019	P&A		PLUG AND ABANDON, 5/8/2018 06:00				
J SAND		5/10/2018	TA		PLUG AND ABANDON, 5/8/2018 06:00				
J SAND		10/9/2019	P&A		PLUG AND ABANDON, 5/8/2018 06:00				
Perforation Data									
Linked Zone			Bnch/Stg	Entered Shot Total	Top (ftKB)		Btm (ftKB)		Date
NIOBRARA, ORIGINAL HOLE NIOBRARA, ORIGINAL HOLE CODELL, ORIGINAL HOLE J SAND, ORIGINAL HOLE J SAND, ORIGINAL HOLE J SAND, ORIGINAL HOLE				6	70.00		70.00		10/14/2019
				6	2,000.00		2,000.00		10/11/2019
				6	2,494.00		2,494.00		10/11/2019
			B	24	6,898.00		6,910.00		1/9/2012
			C	24	7,003.00		7,015.00		1/9/2012
				52	7,134.00		7,147.00		1/9/2012
				24	7,619.00		7,625.00		1/9/2012
				32	7,630.00		7,638.00		1/6/2012
	40	7,642.00		7,652.00		1/6/2012			
Stimulation Intervals									
Zone				Start Date		Top (ftKB)		Btm (ftKB)	
NIOBRARA, ORIGINAL HOLE				1/9/2012		6,898.0		7,015.0	
CODELL, ORIGINAL HOLE				1/9/2012		7,134.0		7,147.0	
J SAND, ORIGINAL HOLE				1/9/2012		7,619.0		7,652.0	
Other In Hole									
Run Date		Des			Make		OD (in)	Top (ftKB)	Btm (ftKB)
5/8/2018		Cast Iron Bridge Plug					3.99	7,569.0	7,571.0
5/9/2018		Cast Iron Bridge Plug					3.99	6,848.0	6,850.0
10/11/2019		Cement Retainer					4	2,399.0	2,400.0
10/11/2019		Cast Iron Bridge Plug w/ 2 SX Cement					4	4,175.0	4,202.0
Logs									
Date		Type				Top, MD (ftKB)		Btm, MD (ftKB)	
11/19/2011		COMPENSATED DENSTIY/NEUTRON				2,700.0		7,832.0	
11/19/2011		HIGH RESLOUTION INDUCTION				782.0		7,852.0	
1/6/2012		CBL/CCL/GR				580.0		7,772.0	
4/19/2017		GYRO				0.0		7,500.0	
10/14/2019						0.0		1,400.0	



P&A Wellbore For State

Well Name: DECHANT D30-20D

DEVIATED, ORIGINAL HOLE, 1/13/2021 9:38:11 AM

Plug Back Total Depths

