

UNION PACIFIC 15-28
Current Wellbore

Rangely Weber Sand Unit

Well Details:	
STATE & CO	CO - Rio Blanco
TWNS & RNG	TN002 & RW102
SECTION	(NENW) 28
API	51030102900
CHEVNO	DE5557

Type	Depth
KB	5306
GL	5292
16in. 0 #/ft, UNKNOWN	0-61', 75 sxs cmt
10.75in. 40.5 #/ft, UNKNOWN	0-1014', 425 sxs cmt
7in. 23 #/ft, J-55	0-5600', 0 sxs cmt
7in. 23 #/ft, N-80	5600-5832', 1000 sxs cmt
5in. 18 #/ft, L-80	5687-6463', 100 sxs cmt
Top Perf	5835
Bot Perf	6388
PBTD	6455
TD	6465

Formation	Depth
Niobrara	2175
Frontier	2921
Frontier Snd	3010
Mowry	3197
Dakota	3280
Morrison	3351
Curtis	3945
Entrada	4130
Carmel	4285
Navajo	4350
Chinle	4943
Shinarump	5080
Moenkopi	5160
Weber	5825

KB 5306
GL 5292

16in. 0 #/ft, UNKNOWN
0-61', 75 sxs cmt

10.75in. 40.5 #/ft, UNKNOWN
0-1014', 425 sxs cmt

7in. 23 #/ft, J-55
0-5600', 0 sxs cmt


7in. 23 #/ft, N-80
5600-5832', 1000 sxs cmt

5in. 18 #/ft, L-80
5687-6463', 100 sxs cmt

GOC_CALC	5636	Cum HCPV
----------	------	----------

Weber 1a	5825	43%	Top Perf 5835
Weber 2	5982		
Weber 3a	6002	63%	
Weber 4	6088		
Weber 5a	6108	85%	
Weber 6	6231		Btm Perf 6388
Weber 7a	6243	100%	
Weber 8	6353		
Weber 9a	6395	100%	
Weber 10			
Weber 11a		100%	

OWC_CALC	6456	PBTD 6455 TD 6465
----------	------	----------------------

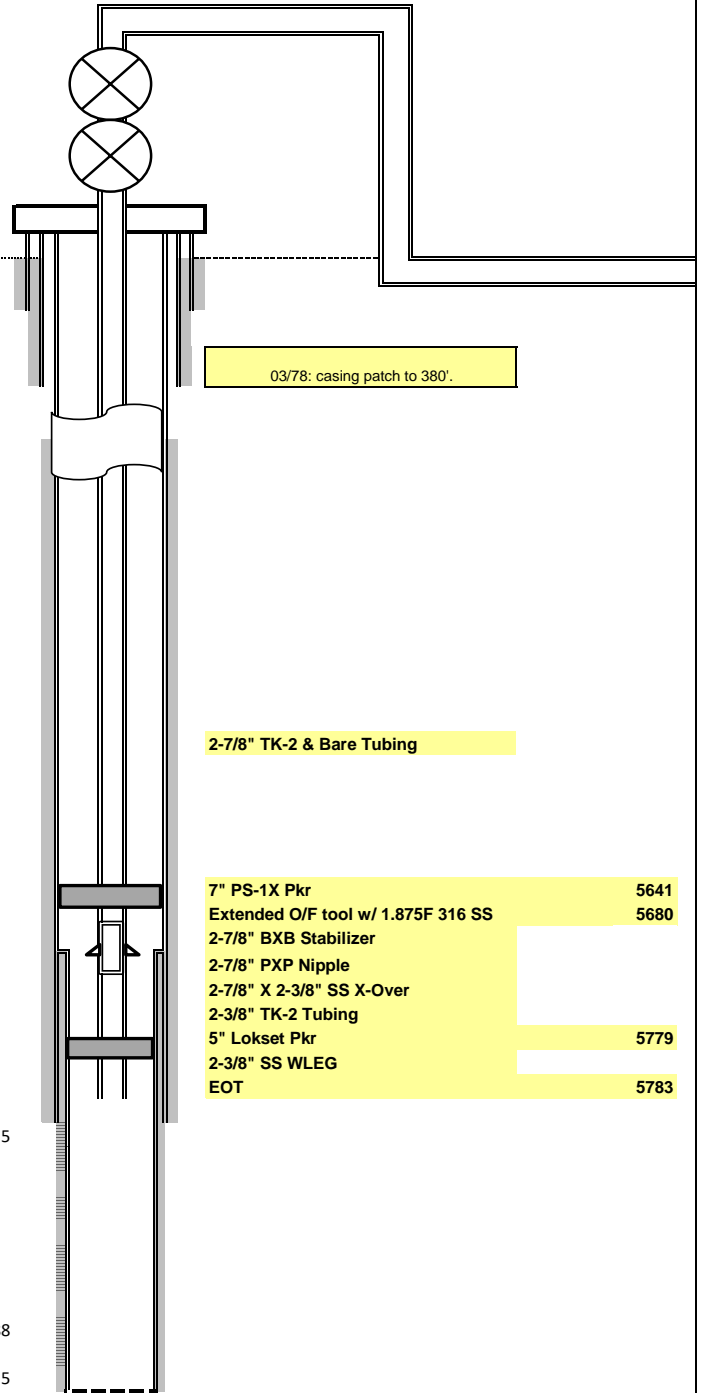

7" PS-1X Pkr	5641
Extended O/F tool w/ 1.875F 316 SS	5680
2-7/8" BXB Stabilizer	
2-7/8" PXP Nipple	
2-7/8" X 2-3/8" SS X-Over	
2-3/8" TK-2 Tubing	
5" Lokset Pkr	5779
2-3/8" SS WLEG	
EOT	5783

****DOUBLE CHECK TUBING LANDING DETAIL IN WELL/TOUR FILE****

Notes:

- 1-
- 2-
- 3-
- 4.-