




00200965

LYCO ENERGY CORPORATION  
**RIGGS**  
**#34-16**

SW/4, SE/4 Sec. 16  
T6N-R65W  
Weld County, Colorado

FORT HAYES ZONE  
PERFORATIONS  
CODELL ZONE  
PERFORATIONS

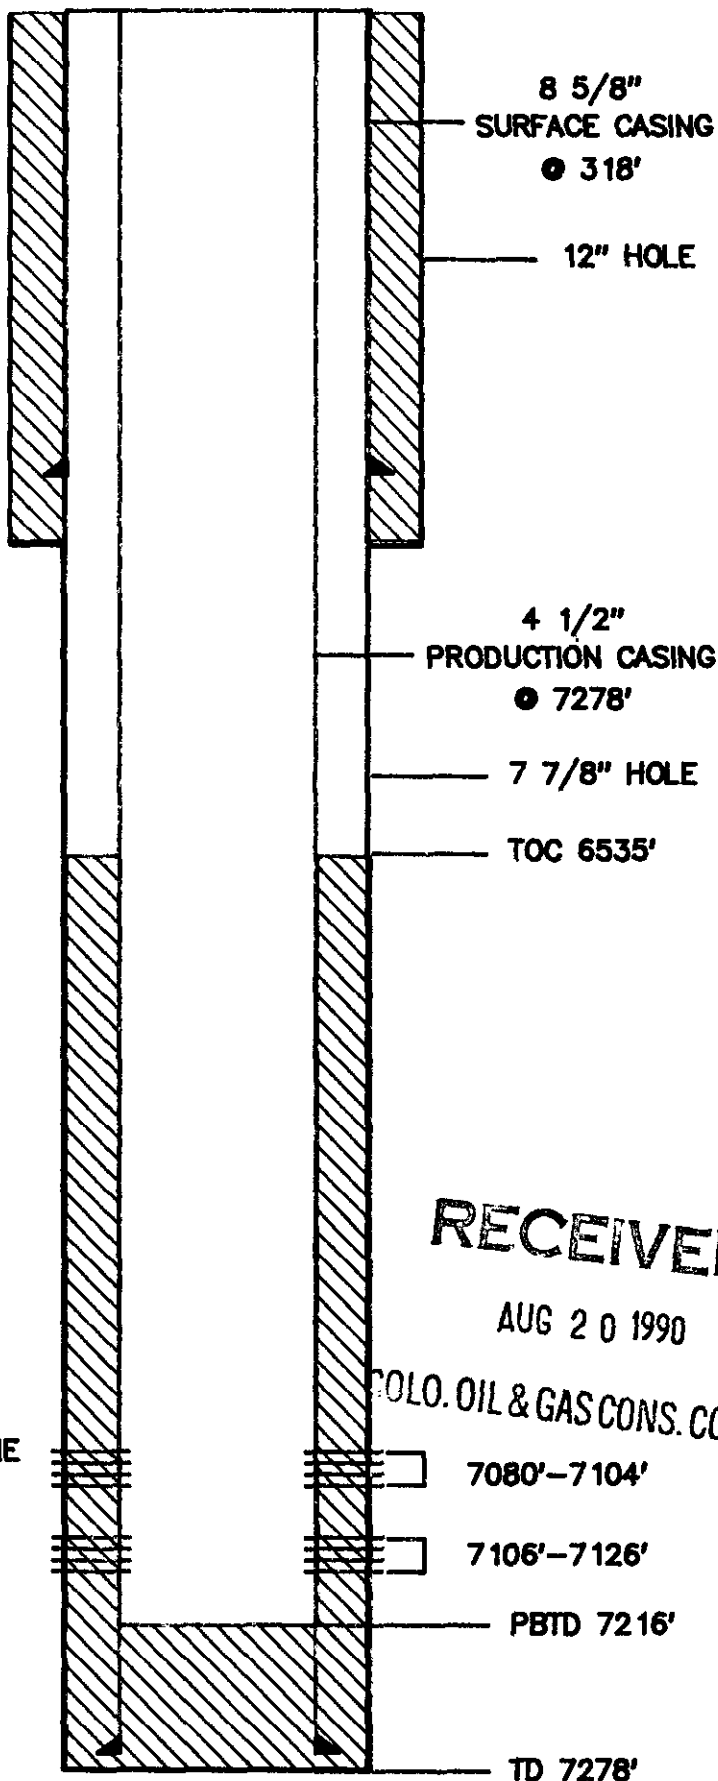

RECEIVED

AUG 20 1990

COLO. OIL & GAS CONS. COMM.