

COLORADO LAND SURVEY MONUMENT RECORD

REPORT ONE MONUMENT ONLY ON THIS FORM

REPRODUCTION OF THIS FORM IS AUTHORIZED.

All items to be filled in by the Land Surveyor using black ink or typewriter. (Except)*

1. TYPE OF MONUMENT (Check one) Section Corner Bench mark
 Quarter Corner Other _____


2. DESCRIPTION OF EVIDENCE FOUND, AND ORIGINAL RECORD CALL, IF KNOWN

East 1/4 corner section 1-8N-82W. Brass cap in a rock pile, 150' North of irrigation ditch, 250' south of east-west road, 400' southwest of bridge over irrigation canal.



3. DESCRIPTION OF MONUMENT AND/OR ACCESSORIES ESTABLISHED BY YOU TO PERPETUATE THE LOCATION OF THIS POINT. IF AN EXISTING MONUMENT, TELL WHY YOU ACCEPTED IT AS VALID. IF YOU ESTABLISHED OR RESTORED A PUBLIC LAND SURVEY MONUMENT, DESCRIBE PROCEDURE AND CONTROL USED.

4. SKETCH SHOWING RELATIVE LOCATION OF MONUMENT AND REFERENCE POINTS. SHOW SUPPORTING AND/OR CONTRADICTORY EVIDENCE WHERE APPLICABLE.

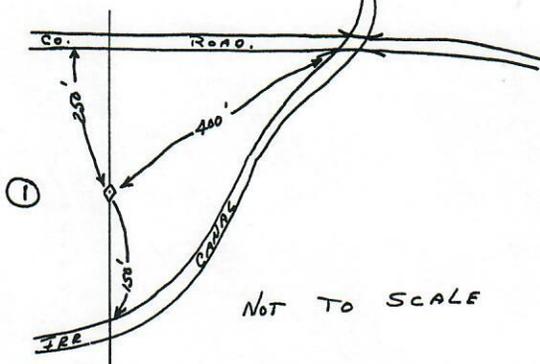

OK

Date of Field Work 8-9-82


5. CERTIFICATION This is to certify that I was in responsible charge of the surveying work described in this record and that to the best of my knowledge the information presented herein is true and correct.

Date 9-30-82


Signature T. Tolson

(Do not fill in)
 Accepted for Filing
 State Board of Registration for Professional Engineers and Land Surveyors
 By Mary L. Schaf
 Date Oct 14, 1982
 RECEIVED AT OFFICE OF THE COUNTY CLERK;
JACKSON COUNTY
 By Sherry J. Woodard
 Date NOV 3 1982
 Record to be filed by Index Reference Number, numerically, then alphabetically, under appropriate Township, Range, and Meridian.

6. LOCATION DIAGRAM 1" = 1 Mile

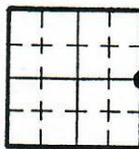

• = Location of Monument

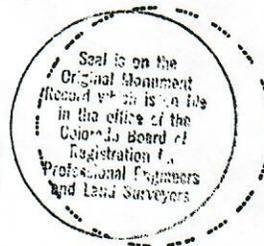

Surveyor's Seal

7. SEC. 1-, T 8N, R 82W, 6th P.M.

8. COUNTY Jackson INDEX REF. NO X-25
COUNTY _____ INDEX REF. NO. _____