

5.


## CERTIFICATION

This is to certify that I was in responsible charge of the surveying work described in this record and that to the best of my knowledge the information presented herein is true and correct.

Signature

James P. P. P.Reg. No. 2957Date 10/27/69

Surveyor's Seal

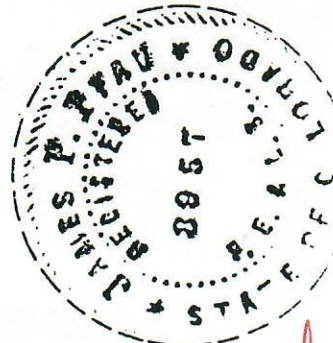

## Accepted for Filing

State Board of Registration for  
Professional Engineers and Land  
Surveyors:

By Kay ShaulkillDate Nov 5, 1969

Received at

Office of the County Clerk;


\_\_\_\_ County;

By \_\_\_\_\_

Date \_\_\_\_\_

Record to be filed by Index Refer-  
ence Number, numerically, then  
alphabetically, under appropriate  
Township, Range, and Meridian.

## 6. LOCATION DIAGRAM

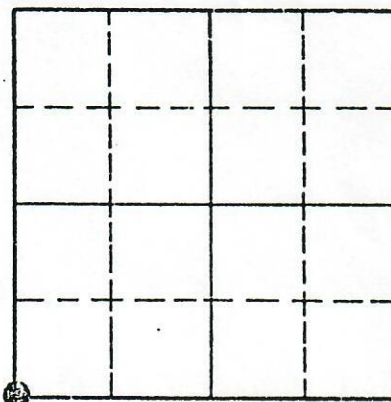

SCA

1" = 1/2

= Locati  
Monur7. SEC. 1, T 2N, R 2W, G 4M P.M.8. COUNTY OR COUNTIES JACKSON9. INDEX REFERENCE NO. 21-V

102 STATE SERVICES BUILDING  
1525 SHERMAN STREET  
DENVER, COLORADO 80203

## COLORADO LAND SURVEY MONUMENT RECORD

All items to be filled in by Land Surveyor using black ink or typewriter.

1. TYPE OF MONUMENT (Check one) ☒ Section Corner ☐ Bench Mark  
☐ Quarter Corner ☐ Other \_\_\_\_\_
2. DESCRIPTION OF EVIDENCE FOUND, AND ORIGINAL RECORD CALL, IF KNOWN. BRASS CAP MOUNTED ON 2 1/2" NOMINAL IRON PIPE, EXTENDING 12" ABOVE GROUND, SURROUNDED BY PILE OF STONES (FOUND), 100 FT. S.E. OF EXISTING 14 FT. DIRT ROAD, 800' S.W. OF BRIDGE AT TOP OF SMALL RIDGE. MARKED: U.S.G.L.O.  
TEN 22 W  
S24S1  
S11S12  
1941
3. DESCRIPTION OF MONUMENT AND/OR ACCESSORIES ESTABLISHED BY YOU TO PERPETUATE THE LOCATION OF THIS POINT.

NONE

Date of Field Work \_\_\_\_\_

4. SKETCH SHOWING RELATIVE LOCATION OF MONUMENT AND REFERENCE POINTS. SHOW SUPPORTING AND/OR CONTRADICTORY EVIDENCE WHERE APPLICABLE.

