


Well Name: LINDBLAD 25-34

VERTICAL, ORIGINAL HOLE, 2/9/2021 9:53:13 AM

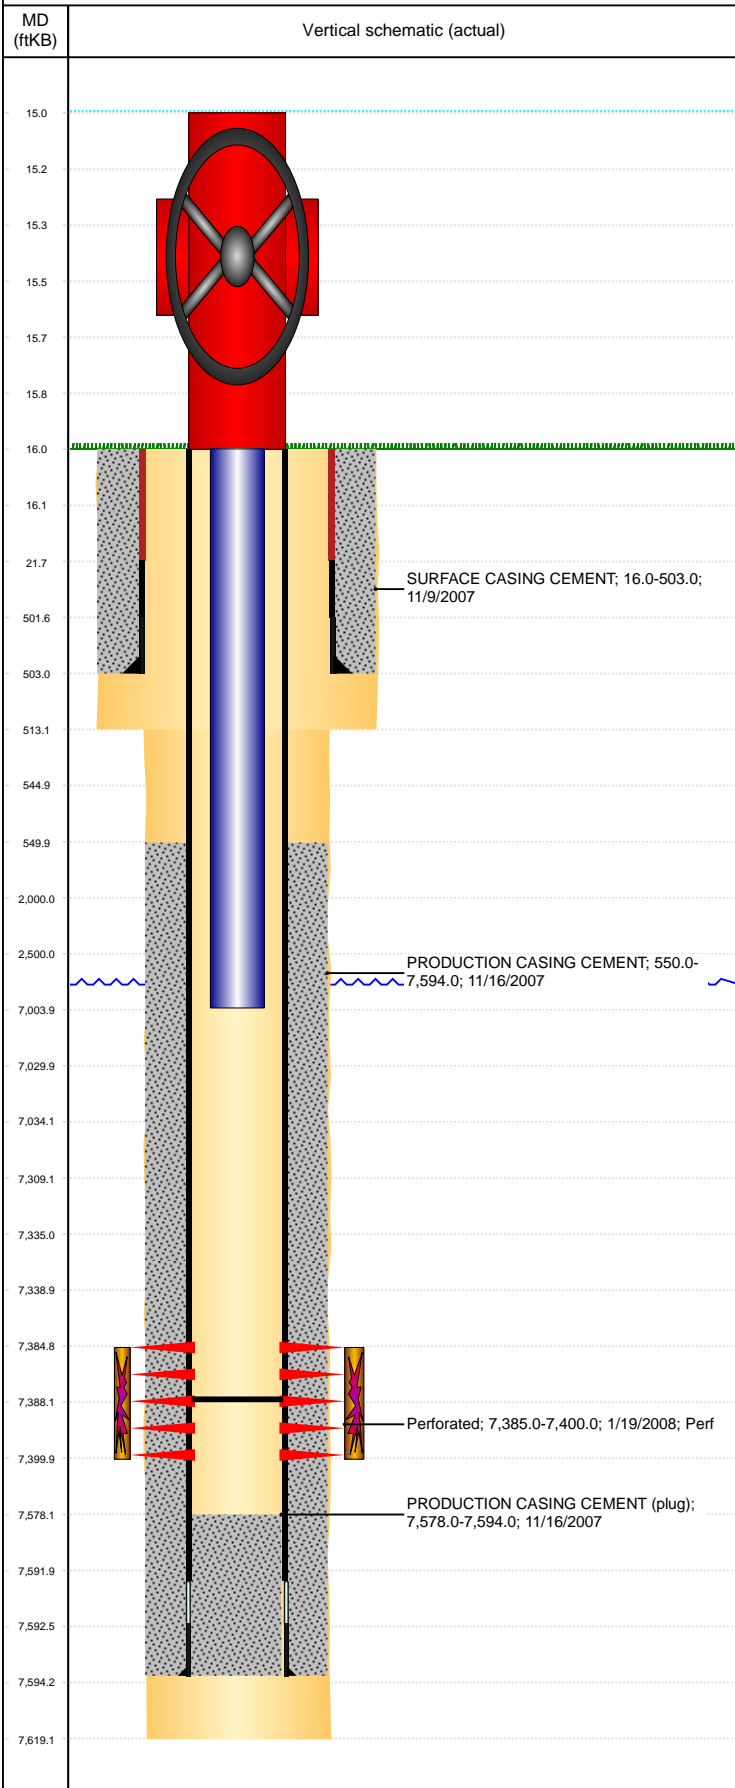

Well Header									
API 05-123-26371		Business Unit DJ BASIN			District 15		Well Config VERTICAL		
KB - GL / MSL (ft... 16.00		Spud Date 11/8/2007		P & A Date		Well Production Status SI			SoRT No
Comment									
Surface Location (Congressional)									
Qtr 3 SE	Qtr 4 SW	Section 25	Twnshp 7	Twنش... N	Range 67	Rng E/... W	Actual Latitude (°) 40.53922000		Actual Longitude (°) -104.84265000
Wellbore Sections									
Section Des			Size (in)			Act Top, MD (ftKB)		Act Btm, MD (ftKB)	
SURFACE			12 1/4			16		513	
PRODUCTION			7 7/8			513		7,619	
Casing Strings									
Csg Des			Run Date		OD (in)	Wt/Len (lb/ft)	Grade	Top, MD (ftKB)	MD (ftKB)
Surface			11/9/2007		8 5/8	24.00		16.0	503.0
Production			11/16/2007		4 1/2	11.60	M-80	16.0	7,594.0
Cement									
Des					Start Date		Top (ftKB)		Btm (ftKB)
SURFACE CASING CEMENT					11/9/2007		16.0		503.0
PRODUCTION CASING CEMENT					11/16/2007		550.0		7,594.0
Zone Statuses									
Zone Name		Status Date	Status	Fluid Type	Job			Prod Method	
CODELL		2/26/2008	PR		DRILLING/COMPLETION - ORIGINAL, 11/8/2007...				
Perforation Data									
Linked Zone			Bnch/Stg	Entered Shot Total	Top (ftKB)		Btm (ftKB)		Date
CODELL, ORIGINAL HOLE					7,385.00		7,400.00		1/19/2008
Stimulation Intervals									
Zone				Start Date		Top (ftKB)		Btm (ftKB)	
CODELL, ORIGINAL HOLE				1/22/2008		7,385.0		7,400.0	
Other In Hole									
Run Date		Des			Make	OD (in)	Top (ftKB)	Btm (ftKB)	
Logs									
Date		Type				Top, MD (ftKB)		Btm, MD (ftKB)	
11/15/2007		COMPENSATED DENSITY				3,650.0		7,589.0	
11/15/2007		INDUCTION				503.0		7,609.0	
12/13/2007		CBL/CCL/GR				911.0		7,547.0	
Plug Back Total Depths									
Date		Type			Com				Depth (ftKB)
12/13/2007		CEMENT PLUG			DEPTH LOGGER				7,547.0
3/13/2008		FILL			TAG FILL				7,388.0