


Hicks B-1, 063-06043 Issue Report



Created on March 4, 2021

Captured: February 23, 2021

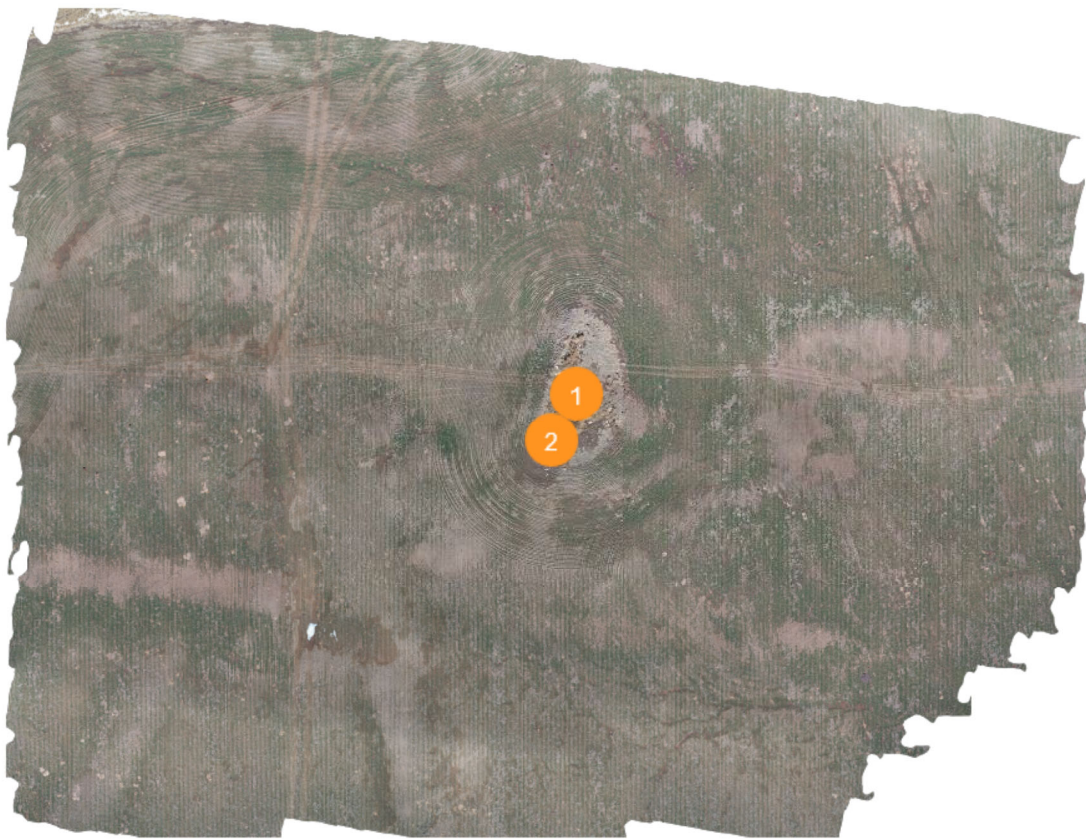

Issue Type	Count
Incomplete Work	2

No.	Summary	Type	Created	Status
2	Pipeline Riser still in place.	Incomplete Work	Mar 4, 2021 at 5:04pm	Open
1	Not ripped	Incomplete Work	Mar 4, 2021 at 5:03pm	Open

2 - Incomplete Work **OPEN**

Feb 23, 2021 at 11:08am



Type

Incomplete Work

Lat/Long

39.08610, -102.40245

Summary

Pipeline Riser still in place.

Created

Mar 4, 2021 at 5:04pm by Craig Quint

1 - Incomplete Work OPEN

Feb 23, 2021 at 11:08am

**Type**

Incomplete Work

Lat/Long

39.08617, -102.40239

Summary

Not ripped

Created

Mar 4, 2021 at 5:03pm by Craig Quint

