



No PR Sussex  
Deepest Offset WW: 1110'  
Fox Hills: 1009' - 1214'  
Upper Pierre Base: 2280'

10 sx at surface


50 sx from 1320'-1370'

25 sx from 7800'-7850'

85 sx from 8190'-8390'

**WELLBORE DIAGRAM**  
**CURRENT WBD**

1644' FNL 1660' FWL

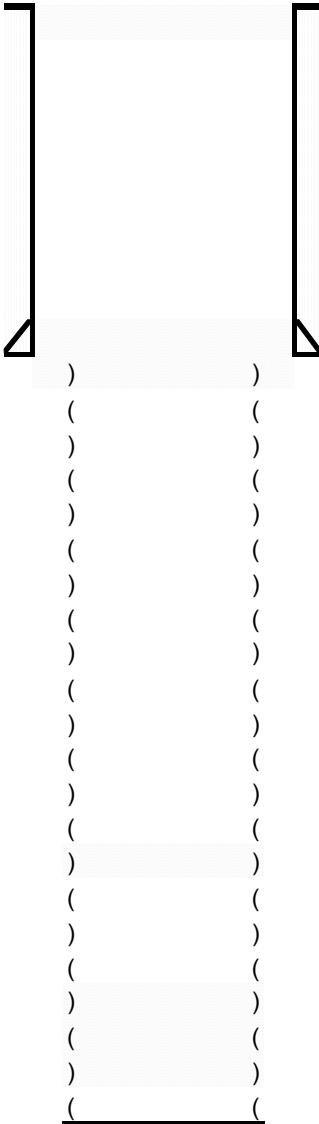

TVD = 8595'      PBTVD =  
MD = 8595'      PBMD =

Operator:	North American Resources Company
Well Name:	Sable Farms 22-31
Lease Number:	
Location:	SENW 31 1S 66W
Field:	Wildcat - #99999
County, State:	Adams, CO
API Number:	05-001-09074
Diagram Date:	10/15/2020
Lat/Long	39.92433      -104.821996

KB 5080'  
GL 5070'  
Spud Date: 3/27/1992

**Surface Casing :**  
8-5/8" 24# set @ 1342'  
Cmt w/ 575 sx

**Production Casing :**  
unsure if casing was set

Formation Tops (none on scout card)  
Nio      7420' estimated from induction log

**Codell**

**Dakota/J Sand**