


Measured Depth - 4850 ft

Legend:

-  Open Hole
  Hole In Pipe
-  Drillable Bridge Plug
  Bottom Plug
-  Casing
  Perforation

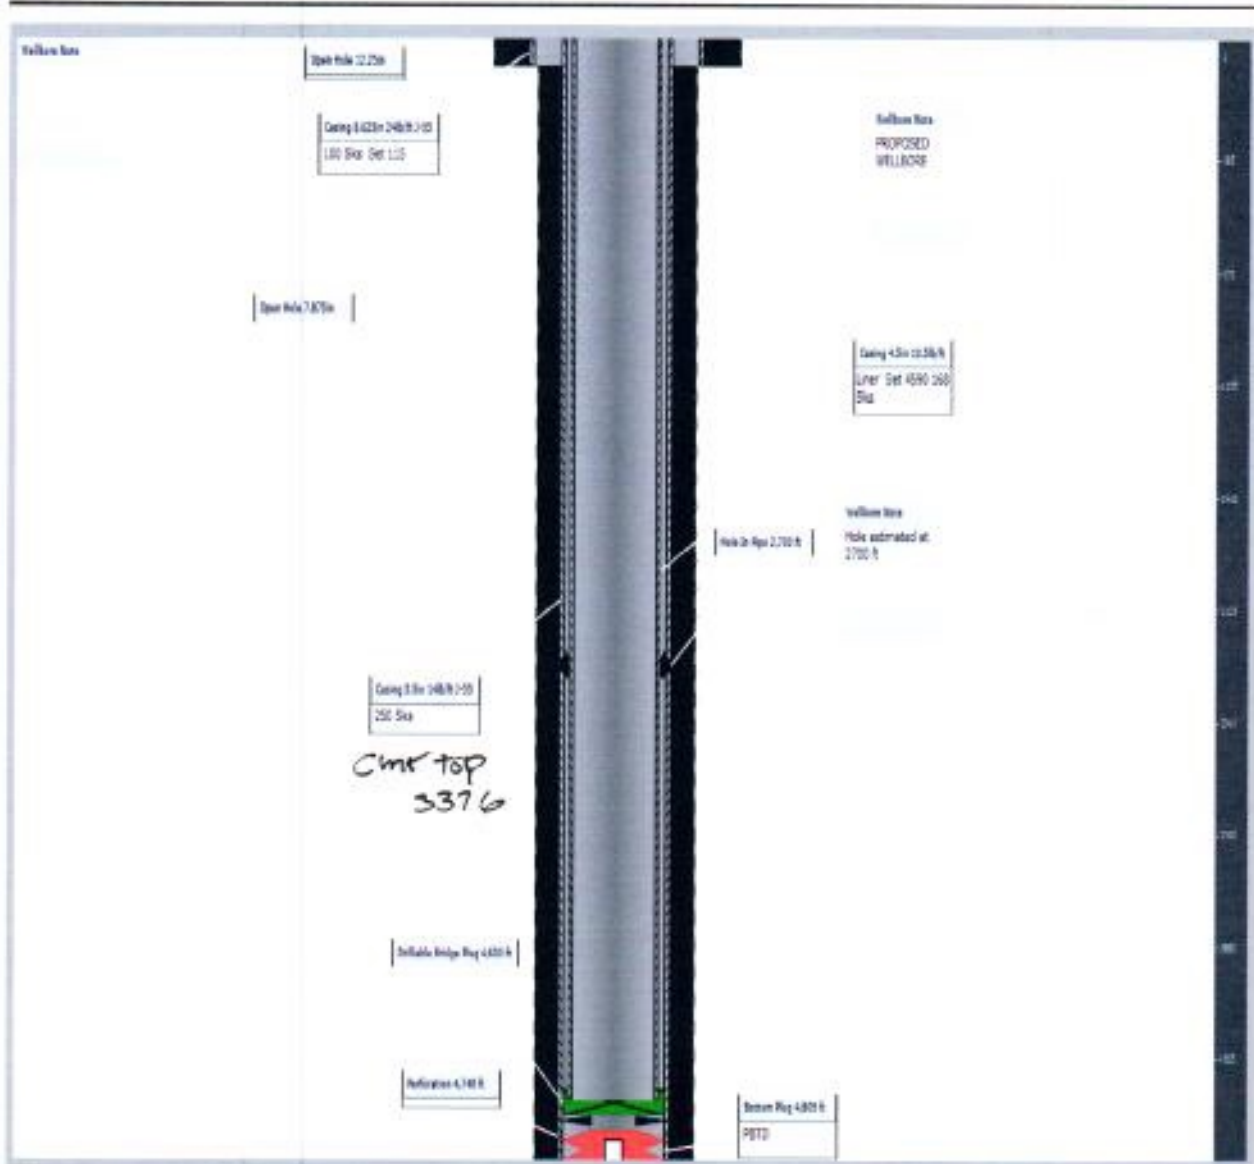

Measured Depth - 4850 ft

Legend:

Open Hole

Drillable Bridge Plug

Casing

Hole In Pipe

Bottom Plug

Perforation