

# TEP Rocky Mtn

## RG 543-18-297

### Plug back and sidetrack diagram


SHL Location:

691' FNL and 2119' FEL  
Sec 18, T2S, R97W  
Garfield County, Colorado

**API # 05-103-12465-00**

Plug #2 length- 551 ft, 41bbls  
232 sks of 17.0 PPG Class G  
cement 0.99 cuft/yield

Plug #1 length- 551 ft, 41bbls  
232 sks of 17.0 PPG Class G cement  
0.99 cuft/yield

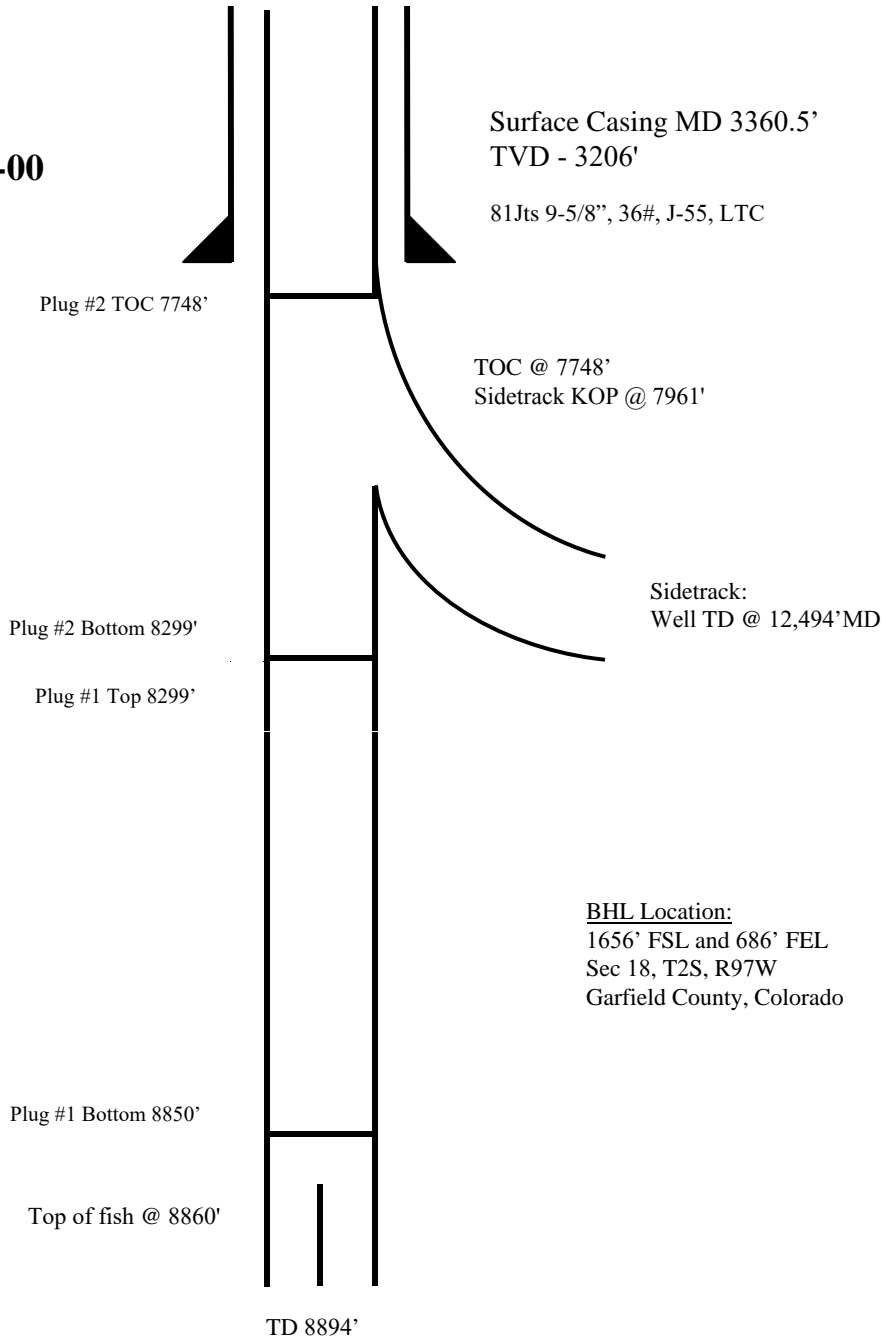

BHL Location:

1656' FSL and 686' FEL  
Sec 18, T2S, R97W  
Garfield County, Colorado