




DRILLING COMPANY, INC. **WICHITA, KANSAS**

Current Wellbore Diagram

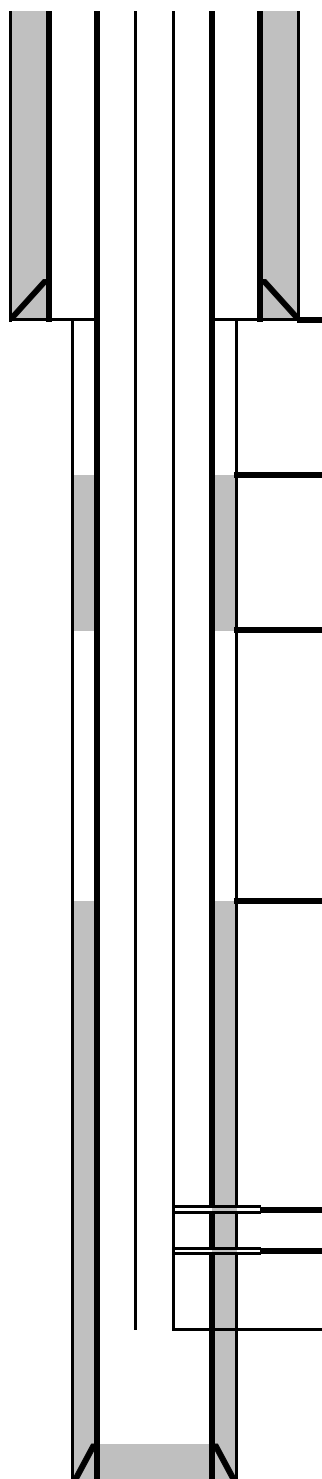

8 5/8" surface csg set @ 287'
 Cemented to surface w/250 sx

Estimated TOC @ 1970' (200 sks @
 1.32 ft3/sk w/40% washout)

Squeezed @ 3026'-57' w/200 sx Class C

TOC @ 4435' (Temp Survey 5/21/1973)

Perfs @ 5296' - 5324' (60 holes) -St. Louis

Perfs @ 5362' - 5402' (102 holes) - Spergen

2 7/8" tbg set @ 5369' (1/11/13)

5 1/2" production csg set @ 5441'
 Cemented w/150 sx

Date: 3/14/2016
 Well Name: Crosby #1
 Location: 1980' FSL & 1997' FWL
 NE/4 NW/4 28-13S-44W
 County: Cheyenne
 State: Colorado
 API: 05-017-06133-00
 GL: 4215'
 KB: 4225'
 Spud Date: 5/5/1973
 DFP Spergen: 5/19/1973
 DFP St. Louis: 1/11/2013

<u>Formation</u>	<u>Depth Top</u>
Greenhorn	1735
Dakota	1942
Cheyenne	2235
Morrison	2370
Stone Corral	3061
Neva	3688
Foraker	3760
Shawnee	4094
Heebner	4281
Missouri	4311
Lansing	4327
Cherokee	4832
Atoka	4988
Morrow	5118
Keyes	5209
St. Louis	5279
Spergen	5359

PBTD = 5404'
 RTD = 5442'