

Foundation Energy Management, LLC

WELLBORE DIAGRAM

Well / Battery	Prospect Name		Total Depth	Current Status
EBELER 13-32	BONNY		1830	Shut in

WELLBORE DIAGRAM

General Info

API #: 05-125-08671

Spud Date: 10/18/2002
Completion Date: 11/19/2002

TVD:
MD: 1,830
Last PBTD: 1,770

Tubing Detail

2 3/8 Size
1560 Estimated depth

Rod Detail


5/8 Size
58 Estimated Joints

Surface Casing

7 inch (OD)
16 # (weight)
grade
351 depth from KB
Surface cement top
125 sacks of cement
9 7/8 inch (OD) HOLE SIZE

Production Casing

4 1/2 inch (OD)
10.5 # (weight)
grade
1820 depth from KB
800 cement top CBL
75 sacks of cement
6 1/4 inch (OD) HOLE SIZE

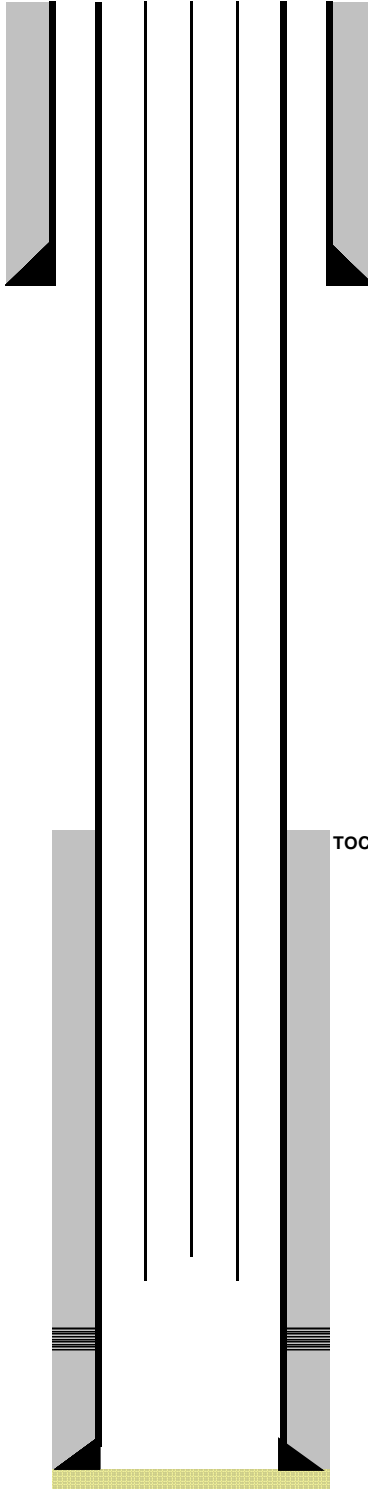

TOC: 800'

NBRR
1595'-1559'

Well Notes:

Foundation Energy Management, LLC

WELLBORE DIAGRAM

Well / Battery	Prospect Name		Total Depth	Current Status
EBELER 13-32	BONNY		1830	Shut in

WELLBORE DIAGRAM

General Info


API #: 05-125-08671

Spud Date: 10/18/2002
Completion Date: 11/19/2002

TVD: 1,830
MD: 1,830
Last PBD: 1,770

Tubing Detail

Rod Detail

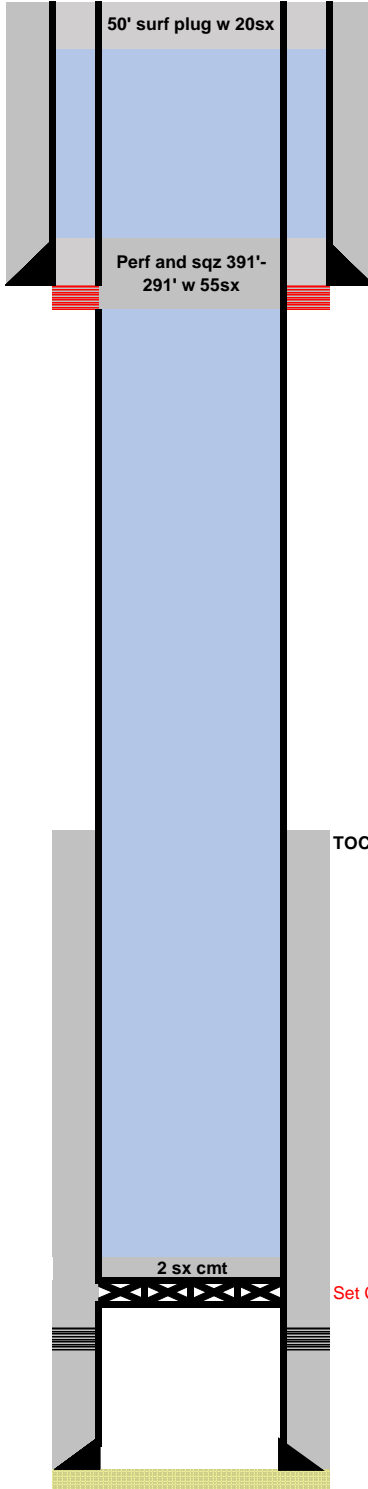

Surface Casing

7 inch (OD)
16 # (weight)
grade
351 depth from KB
Surface cement top
125 sacks of cement
9 7/8 inch (OD) HOLE SIZE

Production Casing

4 1/2 inch (OD)
10.5 # (weight)
grade
1820 depth from KB
800 cement top
75 sacks of cement
6 1/4 inch (OD) HOLE SIZE

Well Notes: