

Foundation Energy Management, LLC
WELLBORE DIAGRAM

Well / Battery	Prospect Name		Total Depth	Current Status
Helling 34-35444	Bonny		1893	SI

WELLBORE DIAGRAM

General Info

API #: 05-125-08367

KB Elevation:
GL Elevation: 3888'

Spud Date: 9/16/2001
Completion Date: 10/12/2001

TVD: 1893'
MD: 1893'
Last PBTD: 1825'

Tubing Detail

2 3/8 inch(OD)
(weight)
1629 depth

Rod Detail

5/8
64

Surface Casing

7 inch (OD)
16 # (weight)
grade
326 depth from KB
0 cement top
150 sacks of cement
9 7/8 inch (OD) HOLE SIZE

Production Casing

4 1/2 inch (OD)
10.5 # (weight)
grade
1866 depth from KB
1100 cement top CBL
75 sacks of cement
6 1/4 inch (OD) HOLE SIZE

TOC: 1100

PERFORATIONS
Niobrara
1550' - 1585'

Well Notes:

Foundation Energy Management, LLC

WELLBORE DIAGRAM

Well / Battery	Prospect Name		Total Depth	Current Status
Helling 34-35444	Bonny		1893	SI

PROPOSED WELLBORE DIAGRAM

General Info

API #: 05-125-08367

KB Elevation:

GL Elevation: 3888'

Spud Date: 9/16/2001

Completion Date: 10/12/2001

TVD: 1893'

MD: 1893'

Last PBDT: 1825'


Tubing Detail

inch(OD)

(weight)

depth

Rod Detail

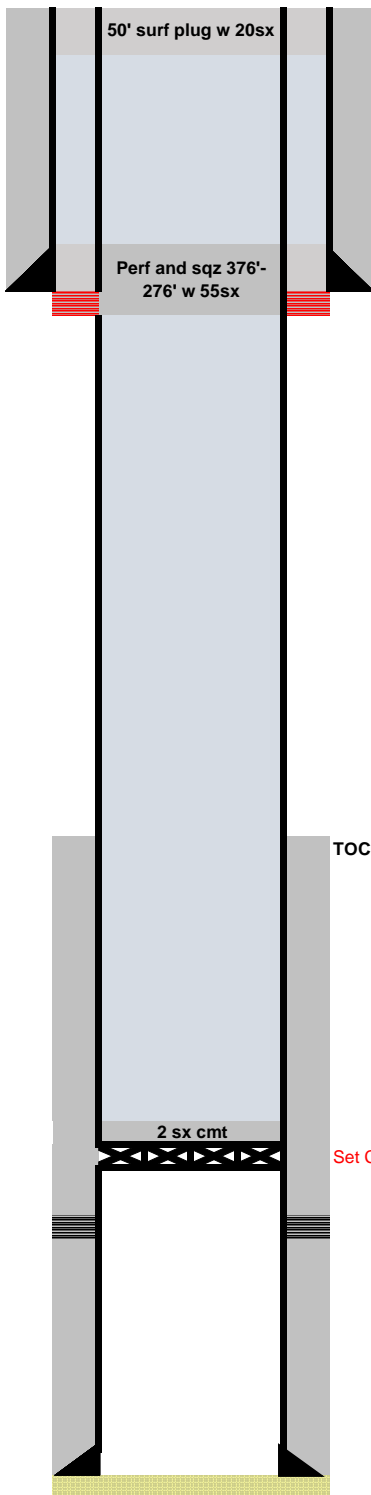

Surface Casing

7 inch (OD)
16 # (weight)
grade
326 depth from KB
0 cement top
150 sacks of cement
9 7/8 inch (OD) HOLE SIZE

Production Casing

4 1/2 inch (OD)
10.5 # (weight)
grade
1866 depth from KB
1100 cement top CBL
75 sacks of cement
6 1/4 inch (OD) HOLE SIZE

Well Notes: