



COORDINATE TABLE



ABBREVIATIONS LEGEND:


SURFACE HOLE LOCATION	(SHL)
LANDING POINT LOCATION	(LP)
TOP OF PRODUCTION ZONE	(TPZ)
BOTTOM OF PRODUCTION ZONE	(BPZ)
BOTTOM HOLE LOCATION	(BHL)
LATITUDE NAD 83	(LAT.83)
LONGITUDE NAD 83	(LONG.83)
LATITUDE NAD 27	(LAT.27)
LONGITUDE NAD 27	(LONG.27)
COLORADO COORDINATE SYSTEM OF 1983 NORTH ZONE	(SPC83)
COLORADO COORDINATE SYSTEM OF 1927 NORTH ZONE	(SPC27)

Note:

1. All (SPC83) and (SPC27) coordinate values are U.S. Survey Feet.
2. All Latitude and Longitude values are decimal degrees.

SCHNEIDER 1414-01H

	(LAT.83)	(LONG.83)	NORTHING EASTING		(LAT.27)	(LONG.27)	NORTHING EASTING	
			(SPC83)	(SPC83)			(SPC27)	(SPC27)
(SHL)	N40.6691018	W104.0625527	1489828.47	3398737.31	N40.6691152	W104.0620481	489827.08	2398887.83
(TPZ)	N40.6689593	W104.0590105	1489792.52	3399720.64	N40.6689726	W104.0585059	489791.12	2399871.19
(BPZ)	N40.6561279	W104.0593682	1485116.77	3399697.37	N40.6561413	W104.0588635	485115.45	2399847.98
(BHL)	N40.6557985	W104.0593774	1484996.72	3399696.77	N40.6558118	W104.0588726	484995.41	2399847.39

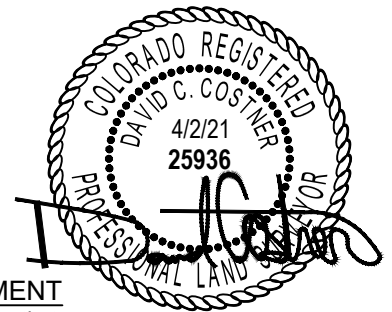

SURVEYOR'S STATEMENT

The undersigned hereby states that the well location shown hereon was staked on the ground based on existing monumentation and/or physical evidence found in the field and is correct to the best of my knowledge, information and belief.



VERDAD RESOURCES
SCHNEIDER 1414-01H
JOB NO. 117800

JLS	06/11/2018	REVISION:	
SHEET :	2 OF 2	INT	DATE
FILE:LO_SCHNEIDER_1414_01H_REV4	PAV	04/02/2021	