

PETRO-LOG, INCORPORATED


SERVING THE ROCKY MOUNTAIN AREA

DATE 09/1/2019 WELL NO. 4 LEASE Nickerson FIELD Gemini
API 123-13942 SWNW 18-7N-58W

Well Bore Prior To Plugging


Well Bore After Plugging

8 5/8" 24# C 216 w/300 SX
Regular w/3% CA CL₂ - Good Return

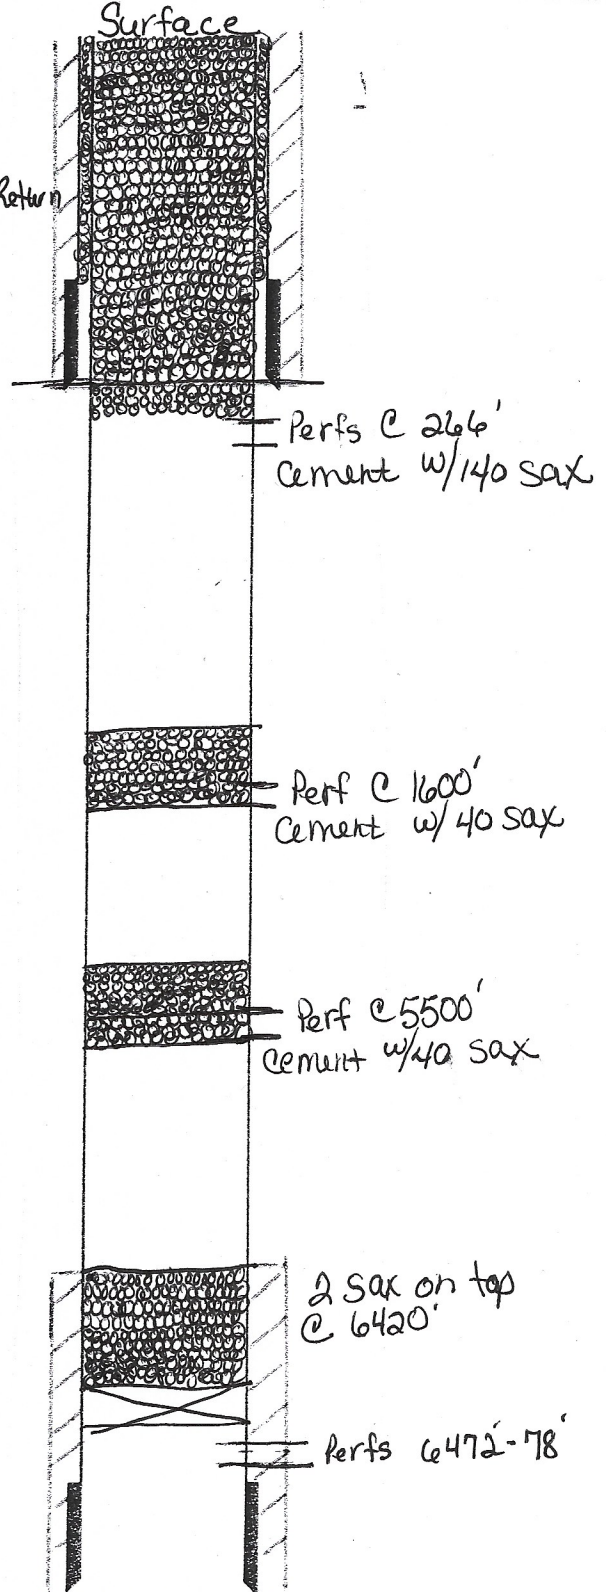

Top Cement 5680'

Perfs 6472-6478'
4 1/2" 11.6# C 6614
w/175 SX 50/50 Poz w/
2% Gel & 10% Salt
PBT D 6592

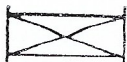

BRIDGE PLUG



PACKER



CENTRALIZER



SCRATCHER



BASKET



PERFORATION

(Use reverse side for additional remarks & sketches.)