


Well Name: NEI C18-22D

DEVIATED, ORIGINAL HOLE, 4/6/2021 11:50:33 PM

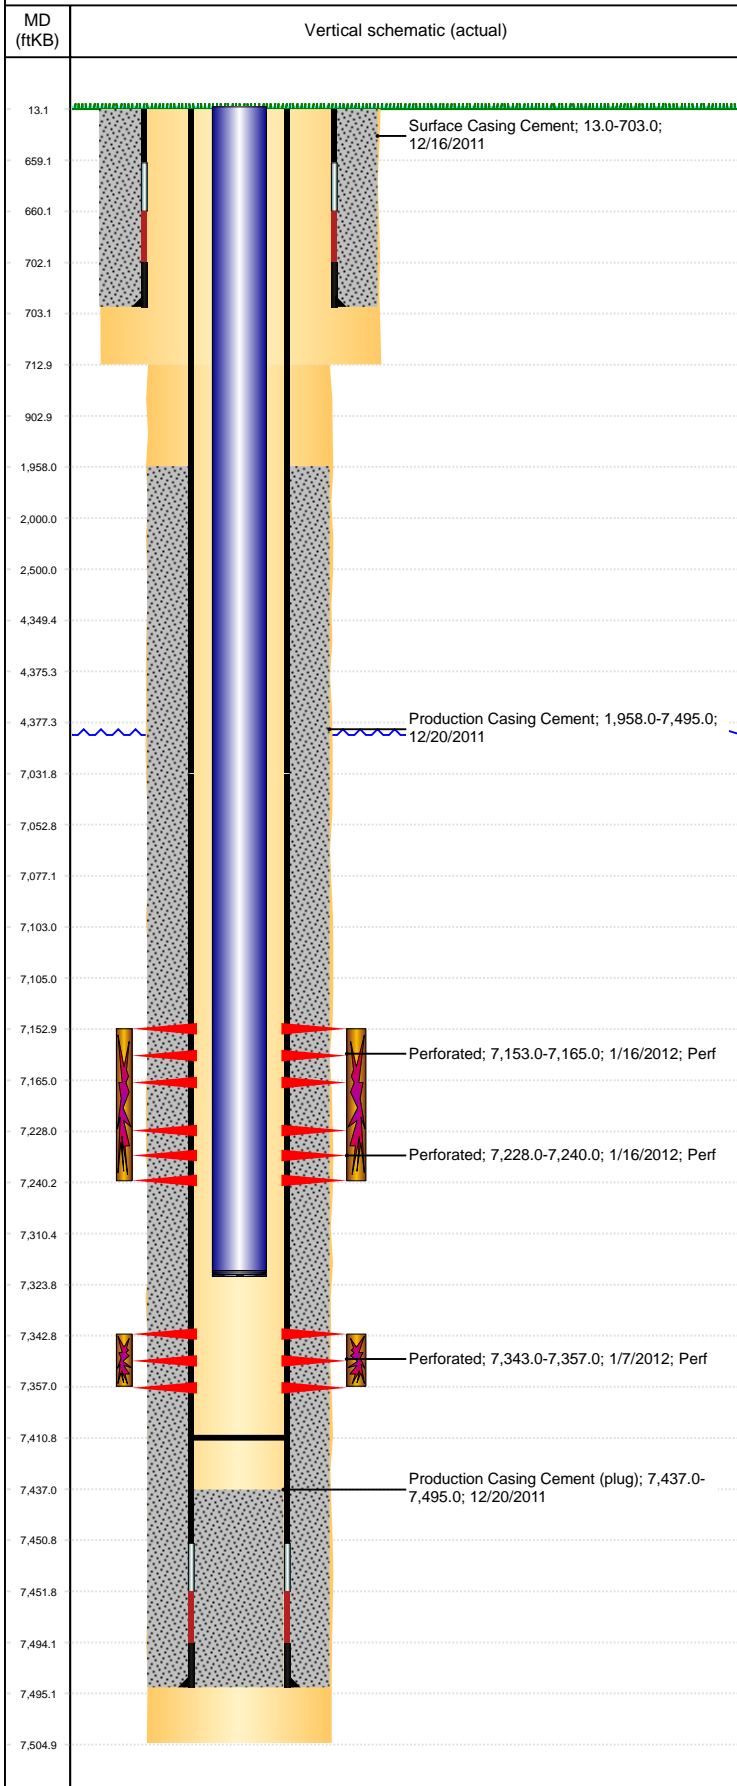

Well Header

API 05-123-34399	Business Unit DJ BASIN	District 15	Well Config DEVIATED
KB - GL / MSL (ft... 13.00	Spud Date 12/16/2011	P & A Date	Well Production Status PR
SoRT No			
Comment			

Surface Location (Congressional)

Qtr 3 NE	Qtr 4 SW	Section 18	Twnshp 4	Twnsh... N	Range 64	Rng E... W	Actual Latitude (°) 40.31188810	Actual Longitude (°) -104.59419895
-------------	-------------	---------------	-------------	---------------	-------------	---------------	------------------------------------	---------------------------------------

Wellbore Sections

Section Des	Size (in)	Act Top, MD (ftKB)	Act Btm, MD (ftKB)
SURFACE	12 1/4	13	713
PRODUCTION	7 7/8	713	7,505

Casing Strings

Csg Des	Run Date	OD (in)	Wt/Len (lb/ft)	Grade	Top, MD (ftKB)	MD (ftKB)
Surface	12/16/2011	8 5/8	24.00	J-55	13.0	703.0
PRODUCTION	12/20/2011	4 1/2	11.60	M-80	13.0	7,495.0

Cement

Des	Start Date	Top (ftKB)	Btm (ftKB)
Surface Casing Cement	12/16/2011	13.0	703.0
Production Casing Cement	12/20/2011	1,958.0	7,495.0

Zone Statuses

Zone Name	Status Date	Status	Fluid Type	Job	Prod Method
CODELL	1/11/2016	TA		HORIZONTAL WELL PREP, 1/7/2016 13:30	
CODELL	3/24/2016	PR		HORIZONTAL WELL PREP, 1/7/2016 13:30	
NIOBRARA	1/11/2016	TA		HORIZONTAL WELL PREP, 1/7/2016 13:30	
NIOBRARA	3/24/2016	PR		HORIZONTAL WELL PREP, 1/7/2016 13:30	

Perforation Data

Linked Zone	Bnch/Stg	Entered Shot Total	Top (ftKB)	Btm (ftKB)	Date
NIOBRARA, ORIGINAL HOLE	B	24	7,153.00	7,165.00	1/16/2012
NIOBRARA, ORIGINAL HOLE	C	24	7,228.00	7,240.00	1/16/2012
CODELL, ORIGINAL HOLE	01	56	7,343.00	7,357.00	1/7/2012

Stimulation Intervals

Zone	Start Date	Top (ftKB)	Btm (ftKB)
NIOBRARA, ORIGINAL HOLE	1/16/2012	7,153.0	7,240.0
CODELL, ORIGINAL HOLE	1/16/2012	7,343.0	7,357.0

Other In Hole

Run Date	Des	Make	OD (in)	Top (ftKB)	Btm (ftKB)

Logs

Date	Type	Top, MD (ftKB)	Btm, MD (ftKB)
12/20/2011	Caliper/Comp. Density/Neutron/GR/SP/ML	2,790.0	7,485.0
12/20/2011	DIL/GR/SP/Caliper	703.0	7,505.0
12/29/2011	CBL/CCL/GR	1,310.0	7,436.0

Plug Back Total Depths

Date	Type	Com	Depth (ftKB)
1/7/2016	FIL		7,444.0
3/24/2016	FILL		7,410.9