


CM Production Bond Claim: Task 3.1 - Mechanical Integrity Test - 324634, 057-06108
Margaret Spaulding 14

Prepared 3/2/2021

FIELD NAME Lone Pine
FIELD NUMBER 51375

LOCATION
Basin North Park
Location-Section-Township-Range SWSE 28 9N81W
Location-Lat/Long 40.717416/-106.499149
Elevation 8,222 KB
8,285 GR

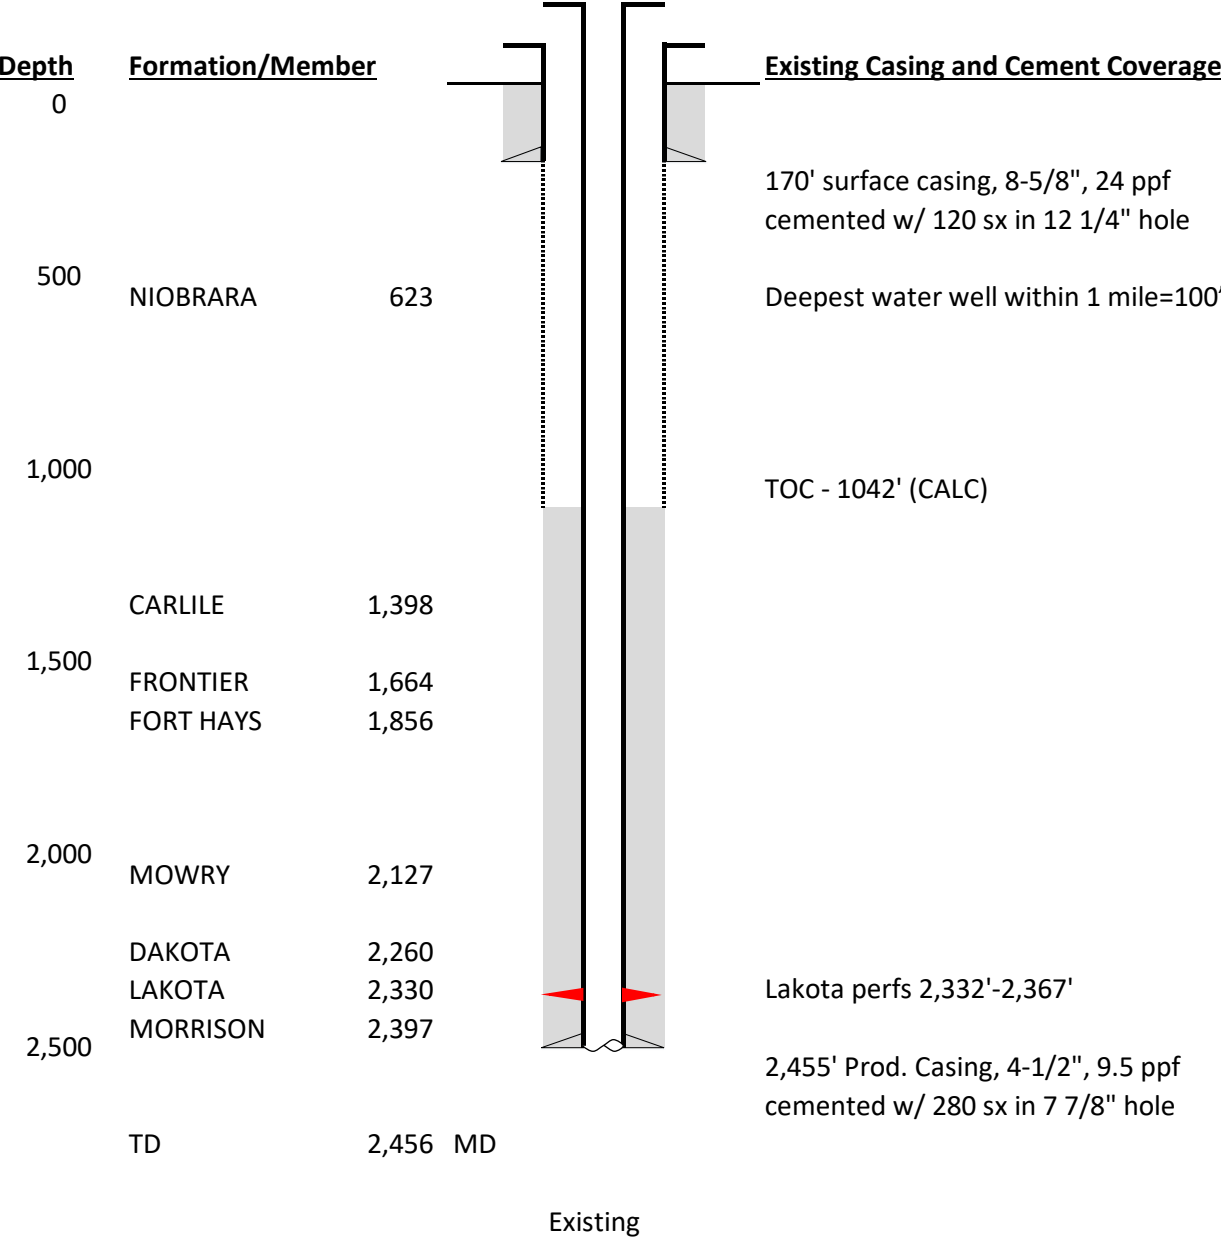

COGCC Document No.

Status SI 8/1/2014
Notes:
Spud 6/18/1974
Last MIT NA
Pump jack Yes
Rods and pump ?
Tubing size 2-3/8" ?
Tubing depth 2294' ?
Need to pull rods & pump

