


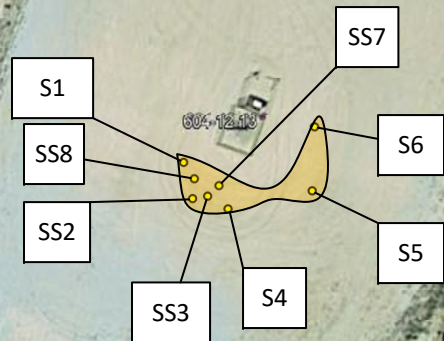

• No Scale •



© 2021 Google

Google Earth



● - Grab sampling location

■ - Historic release area

Pad: 604-12-13 (Facility ID 460326)

Area: Cascade (Garfield County)

Legal: NWSW, Sec. 4, T6S, R97W, 6<sup>th</sup>