

WELLBORE DIAGRAM

CURRENT WBD

1980' FNL 660' FWL




Deepest WW: 1321'
 Fox Hills 1039-1241
 Upper Pierre Base: 2317'

Pump 10 sx at surface
 Calc 132' to surface

Pumped 20 sx @ 1300', ETOC @ 1036'

Pumped 55 sx @ 6650'
 ETOC @ 5925'

Pumped 30 sx at 8164'
 calc TOC @ 7769'

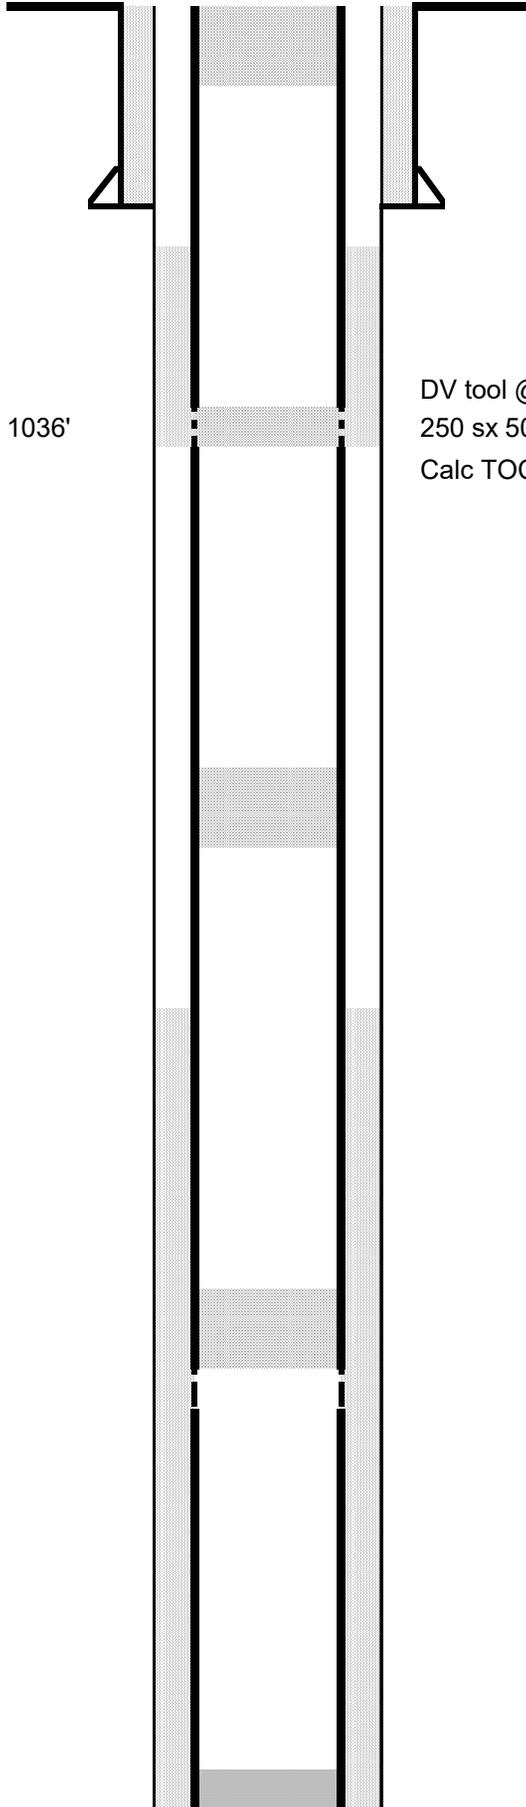

TVD = PBTVD =
 MD = 8285' PBMD = 8223'

Operator:	Cutler Brother
Well Name:	Supers 1
Lease Number:	
Location:	SWNW 32 1S 66W
Field:	Bugle
County, State:	Adams, CO
API Number:	05-001-07002
Diagram Date:	7/1/2020
Lat/Long	39.923588 -104.806608

KB 5087'
GL 5077'
Spud Date: 4/9/1975

Surface Casing

(12-1/2" Hole Size) 8-5/8" 24# csg set @ 151'
 w/ 170sx cmt

Production casing

(7-7/8" Hole Size) 4-1/2" 11.6# csg set @ 8285'
 w/ 300 sx 50/50 pozmix

Tubing Detail:

TOC = 6624' (calc w/ 7-7/8" hole)

Formation Tops:

Base of FH	1241' (DWR)
Sussex	4932'
Niobrara	7353'
Carlile	7819'
Bentonite	8072'
D-Sand	8162'
J-Sand	8203'

Perforations

	Top	Bottom
D Sand	8164'	8170'