

99999999

PLAT SHOWING

ESTES SMELTING REFINING & MINING CO. WELL

08105364

Field: \_\_\_\_\_

Well: Gulf-State #1-34

Range: 90 West Township 8 North

Section: 34

Meridian: 6th P.M. County: Moffat



State: Colorado

Well Elev. (Grd) 6417

NW Cor.

R 90 W

NE Cor.

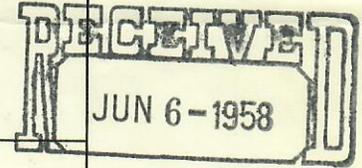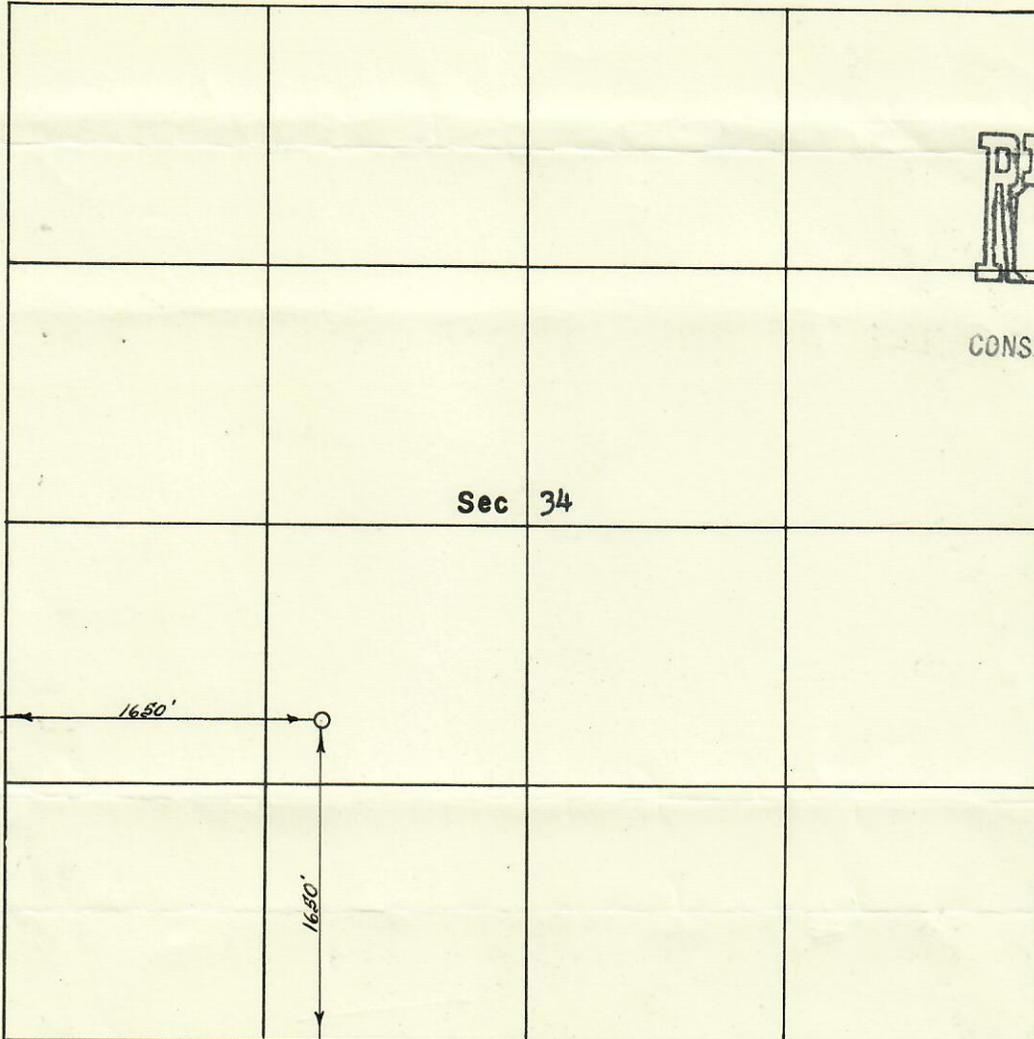

OIL & GAS CONSERVATION COMMISSION

T  
8  
N

Sec 34

SW Cor.

SE Cor.

Scale: 1" = 1000'

I, Arthur Todd of Wheat Ridge, Colorado, do  
name town state

hereby certify that this plat correctly shows the location of the U.S. Smelting

Company Well Gulf State #1-34 staked, May 29, 1958 and checked by me; that

said well is located at a point 1650 feet North and 1650 feet East of the  
SW Corner.

Township 8 North Range 90 West of the 6th P.M., State of Colorado

TODD ENGINEERING COMPANY

3701 Estes Street  
Wheat Ridge, Colorado.

Signed: Arthur Todd

