WELLBORE SCHEMATIC

Current

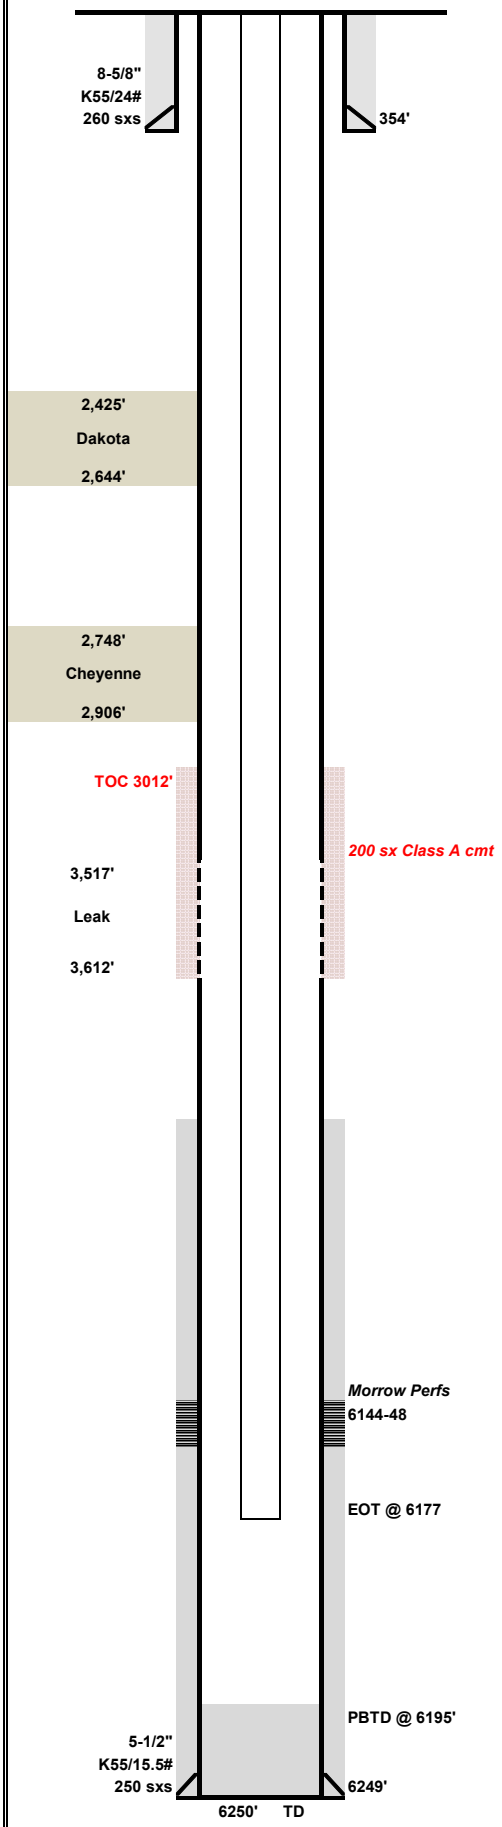

Lease:	**Bledsoe Ranch Unit**			Well No.	**Berge #4**
API No.	05-017-06825			Status	PR
Location:	SE/NE, Sec. 1, T13S-R51W				
County:	Cheyenne	State:	CO	Field:	Bledsoe Ranch
TD	6250'	GL	4739'	Spud Date:	
PBTD	6176'	KB	4749'	Comp Date:	
Current Perfs/OH:	6,144'-48'	Current Zone:		Morrow	

Surface Equipment

Unit Make:		Unit Size:	
Unit S/N:		Unit Rotation:	
SPM:	Stroke Length:	Unit Sheave:	
Prime Mover:		Motor Sheave:	
Motor S/N:		Motor RPM:	

Casing Breakdown

	Size	Grade / Wt	Depth	Hole Size	Cement
Surface	8-5/8"	K55/24#	354'		260 sxs
Production	5-1/2"	K55/15.5#	6249'		250 sxs
Production					
Production					
Liner					

Tubing Breakdown

Qty	Description	Footage
		TOTAL	**0.00'**

Rod Breakdown

Qty	Description	Footage
		TOTAL	**0.00'**

Comments

Casing leak isolated 3,517'-3,612'
Taking water 7/10 BPM on vaccum
Pump into at 50 PSI 1.5 BPM

PREPARED BY:	JH	UPDATED:	8/1/2012