

Wellbore Diagram

<u>Lease & Well No.</u>	<u>McClintock Et Al #1</u>
<u>Field Name</u>	<u>Wattenberg</u>
<u>Location</u>	<u>SHL: 40.122059°N/-104.492301°E; NESE S24 T2NR64W 6PM</u>
<u>K.B. Elevation</u>	<u>4,903'</u>
<u>D.F. Elevation</u>	<u></u>
<u>Ground Level</u>	<u>4,894'</u>


<u>Operator</u>	<u>Juniper Oil and Gas Company</u>
<u>County & State</u>	<u>Weld County, Colorado</u>
<u>API No.</u>	<u>05-123-06133</u>

<u>Surface Casing</u>					
<u>Hole Size</u>	<u>12 1/4"</u>	<u>Csg Wt</u>	<u>32.0#</u>	<u>Depth</u>	<u>166'</u>
<u>Csg Size</u>	<u>8 5/8"</u>	<u>Sx. Cmt.</u>	<u>150 sx</u>	<u>TOC @.</u>	<u>Surface</u>
<u>Intermediate Casing</u>					
<u>Size (OD)</u>	<u>n/a</u>	<u>Weight</u>	<u></u>	<u>Depth</u>	<u></u>
<u>Grade</u>	<u></u>	<u>Sx. Cmt.</u>	<u></u>	<u>TOC @.</u>	<u></u>
<u>Production Casing</u>					
<u>Hole Size</u>	<u>7 7/8"</u>	<u>Weight</u>	<u></u>	<u>Depth</u>	<u>7,460'</u>
<u>Csg Size</u>	<u></u>	<u>Stg 1 Sx. Cmt.</u>	<u></u>	<u>TOC @.</u>	<u></u>
<u>DV Tool</u>	<u></u>	<u>Stg 2 Sx. Cmt.</u>	<u></u>	<u>TOC @.</u>	<u></u>

Calc
CBL

Well History

Spud	4/29/1966
P&A	6/14/1966

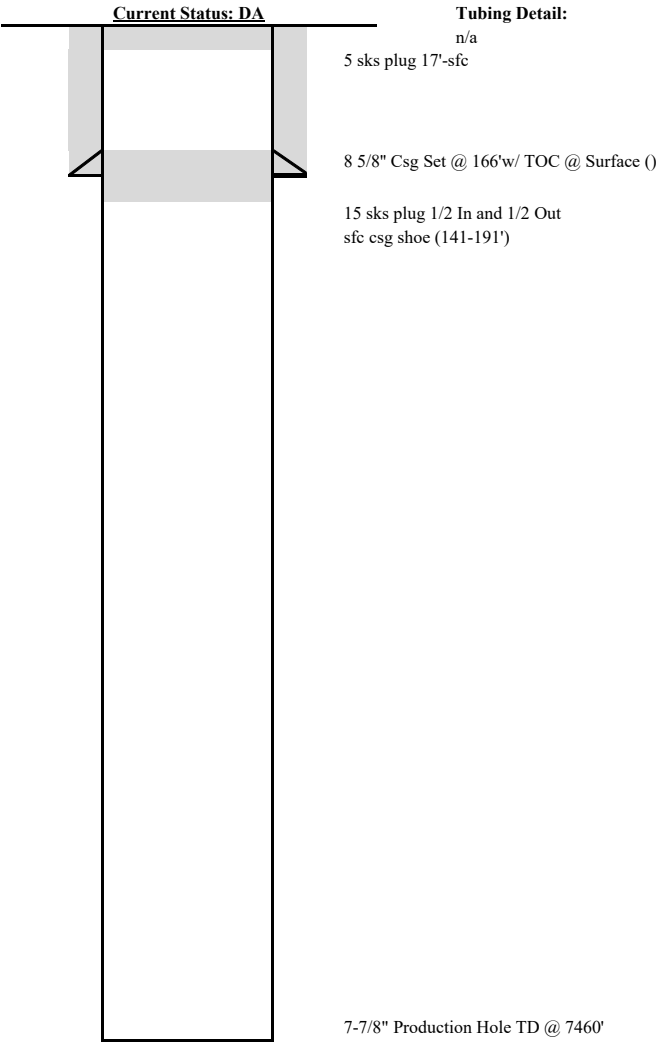

<u>Formation Record</u>	<u>Depth</u>
B/ Fox Hills	813'
Sussex	
Niobrara	6,628'
Niobrara 'B'	
Niobrara 'C'	
Ft Hays	6,902'
D-Sand	7,313'
J-Sand	7,374'

<u>Plug Back Depth</u>	<u>Surface</u>
<u>Total Depth</u>	<u>7,460'</u>

