

Wellbore Diagram

Lease & Well No.	McClintock Et Al #1
Field Name	Wattenberg
Location	SHL: 40.122059°N/-104.492301°E; NESE S24 T2NR64W 6PM
K.B. Elevation	4,903'
D.F. Elevation	
Ground Level	4,894'


Operator	Juniper Oil and Gas Company
County & State	Weld County, Colorado
API No.	05-123-06133

Surface Casing				
Hole Size	12 1/4"	Csg Wt	32.0#	Depth 166'
Csg Size	8 5/8"	Sx. Cmt.	150 sx	TOC @ Surface
Intermediate Casing				
Size (OD)	n/a	Weight		Depth
Grade		Sx. Cmt.		TOC @
Production Casing				
Hole Size	7 7/8"	Weight		Depth 7,460'
Csg Size		Stg 1 Sx. Cmt.		TOC @
DV Tool		Stg 2 Sx. Cmt.		TOC @

Calc
CBL

Well History

Spud	4/29/1966
P&A	6/14/1966

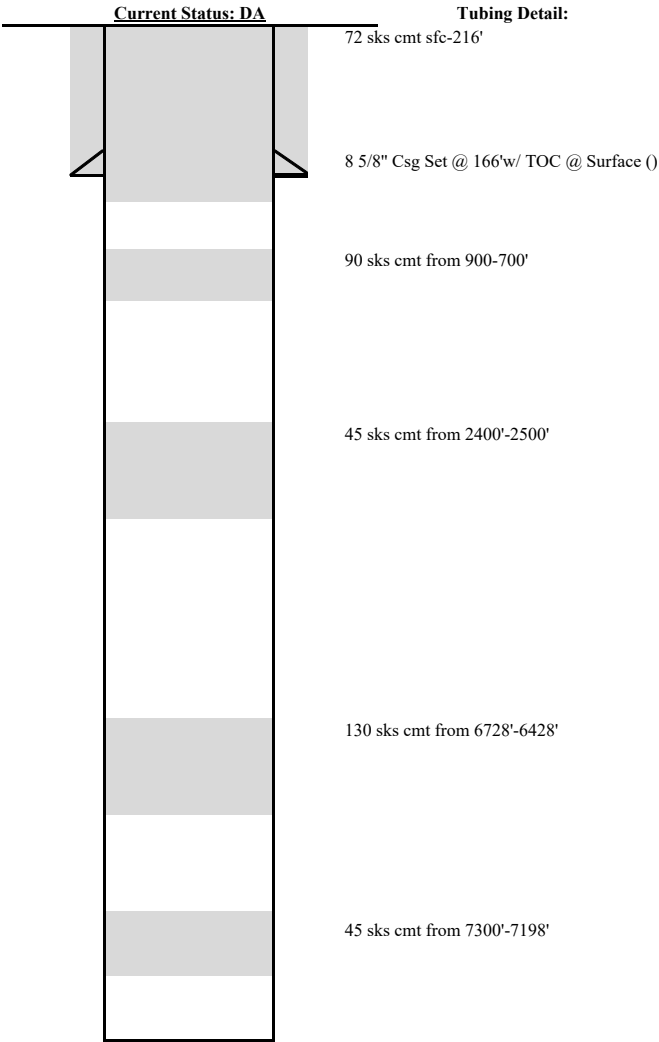

Formation Record	Depth
B/ Fox Hills	813'
Sussex	
Niobrara	6,628'
Niobrara 'B'	
Niobrara 'C'	
Ft Hays	6,902'
D-Sand	7,313'
J-Sand	7,374'

Plug Back Depth	Surface
Total Depth	7,460'

