


Equity Oil & Gas
Emerald #C-134
API # 103-05446

3' of cement
to surface

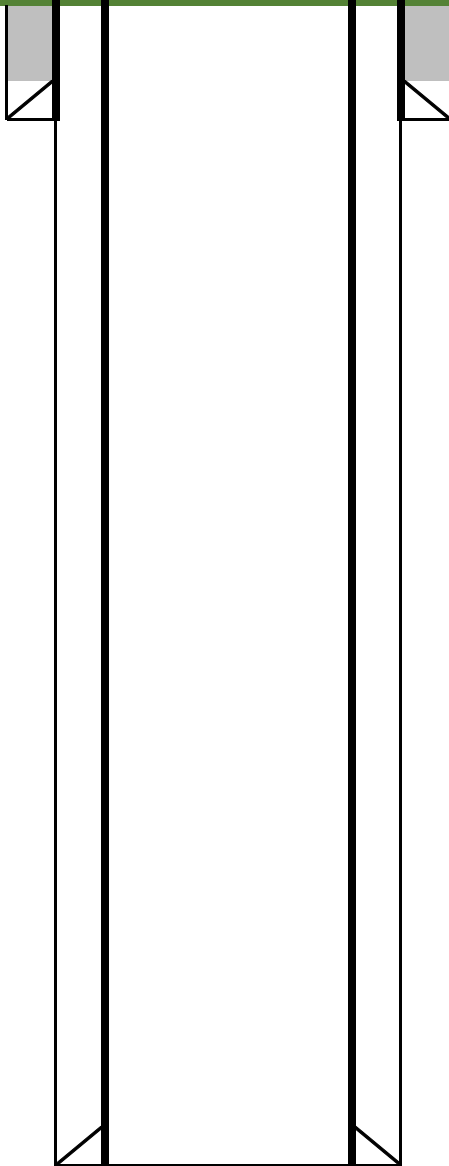

10 3/4" Csg set @ 28' to surface