


Wellbore Diagram

Well Name:	F Wilson 3
County, State	Moffat, CO
Legal Description:	LOT 6 SW 15-12N-100W
API:	05-081-05577
SHL:	660' FSL 1980' FWL
Updated By:	Jeff Bluemel
Date Updated:	6/23/2021
Reviewed By:	Juan Sosa
Reviewed Date:	1/14/2020
Spud Date:	4/12/1934
TD Date:	5/27/1934
IP Date:	
Well TMD:	2,894
Orientation:	Vertical
Plug Back MD:	
Bridge Plug MD:	
Producing Frac Jobs:	Open Hole

Latitude	40.994689
Longitude	-108.622509

As Of Wireline	11/26/2019
----------------	------------

All measurements are in KB & MD unless otherwise specified.

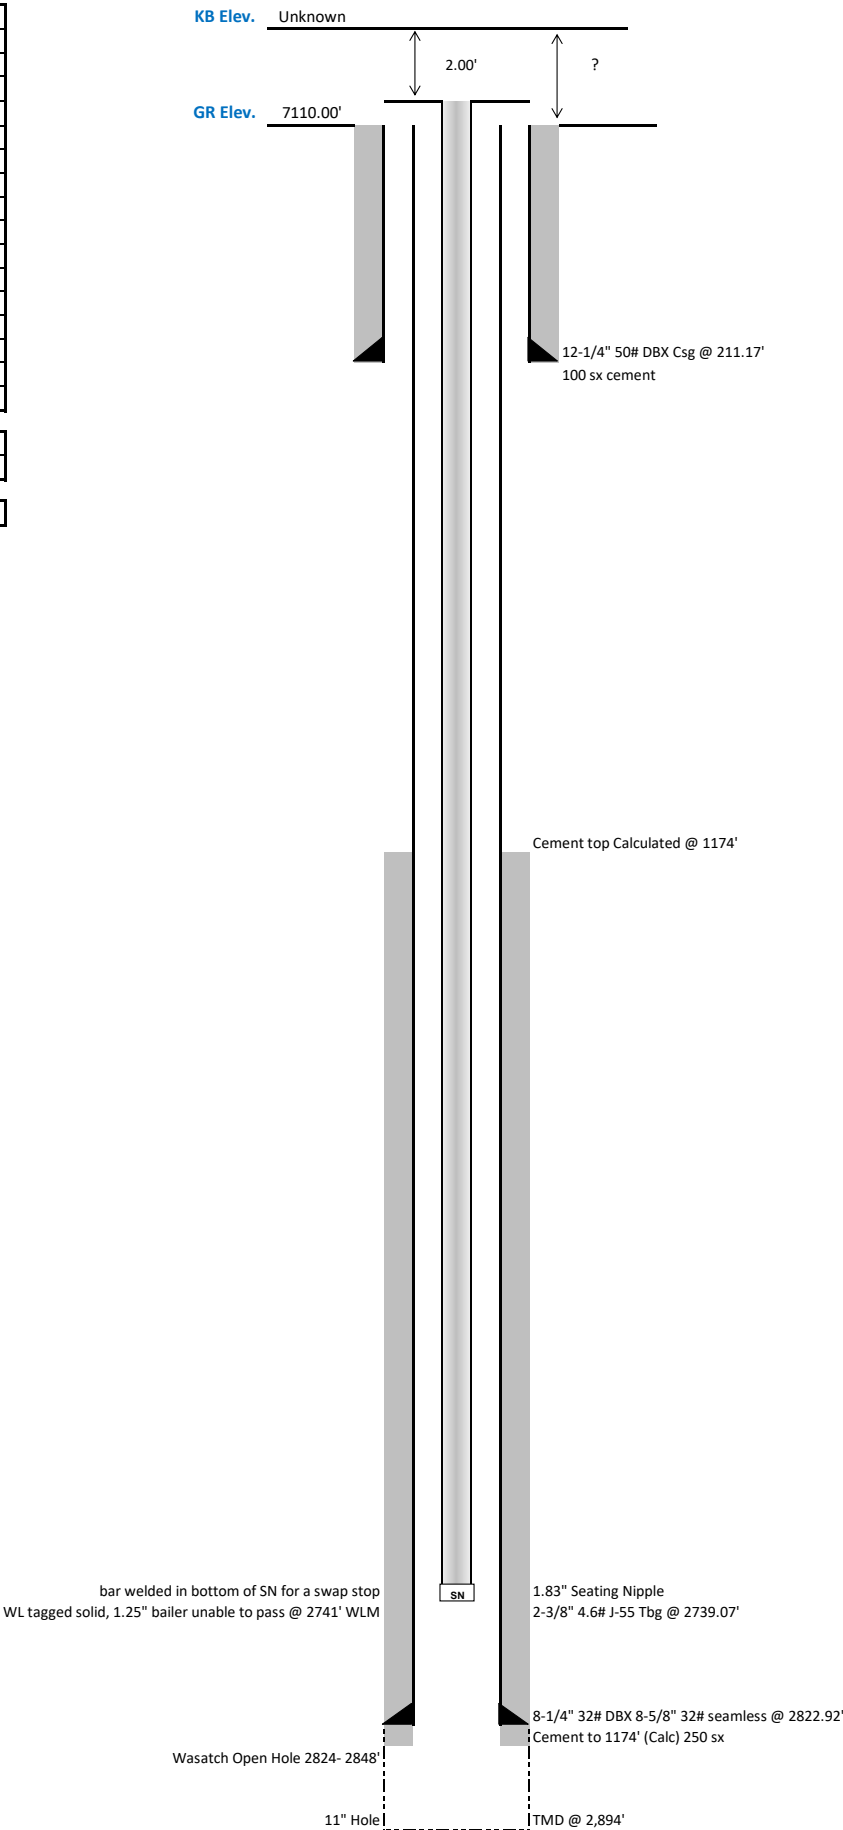

[illegible]