


Well Name: BUTTERBALL D19-17D

DEVIATED, ORIGINAL HOLE, 7/9/2021 11:08:47 AM

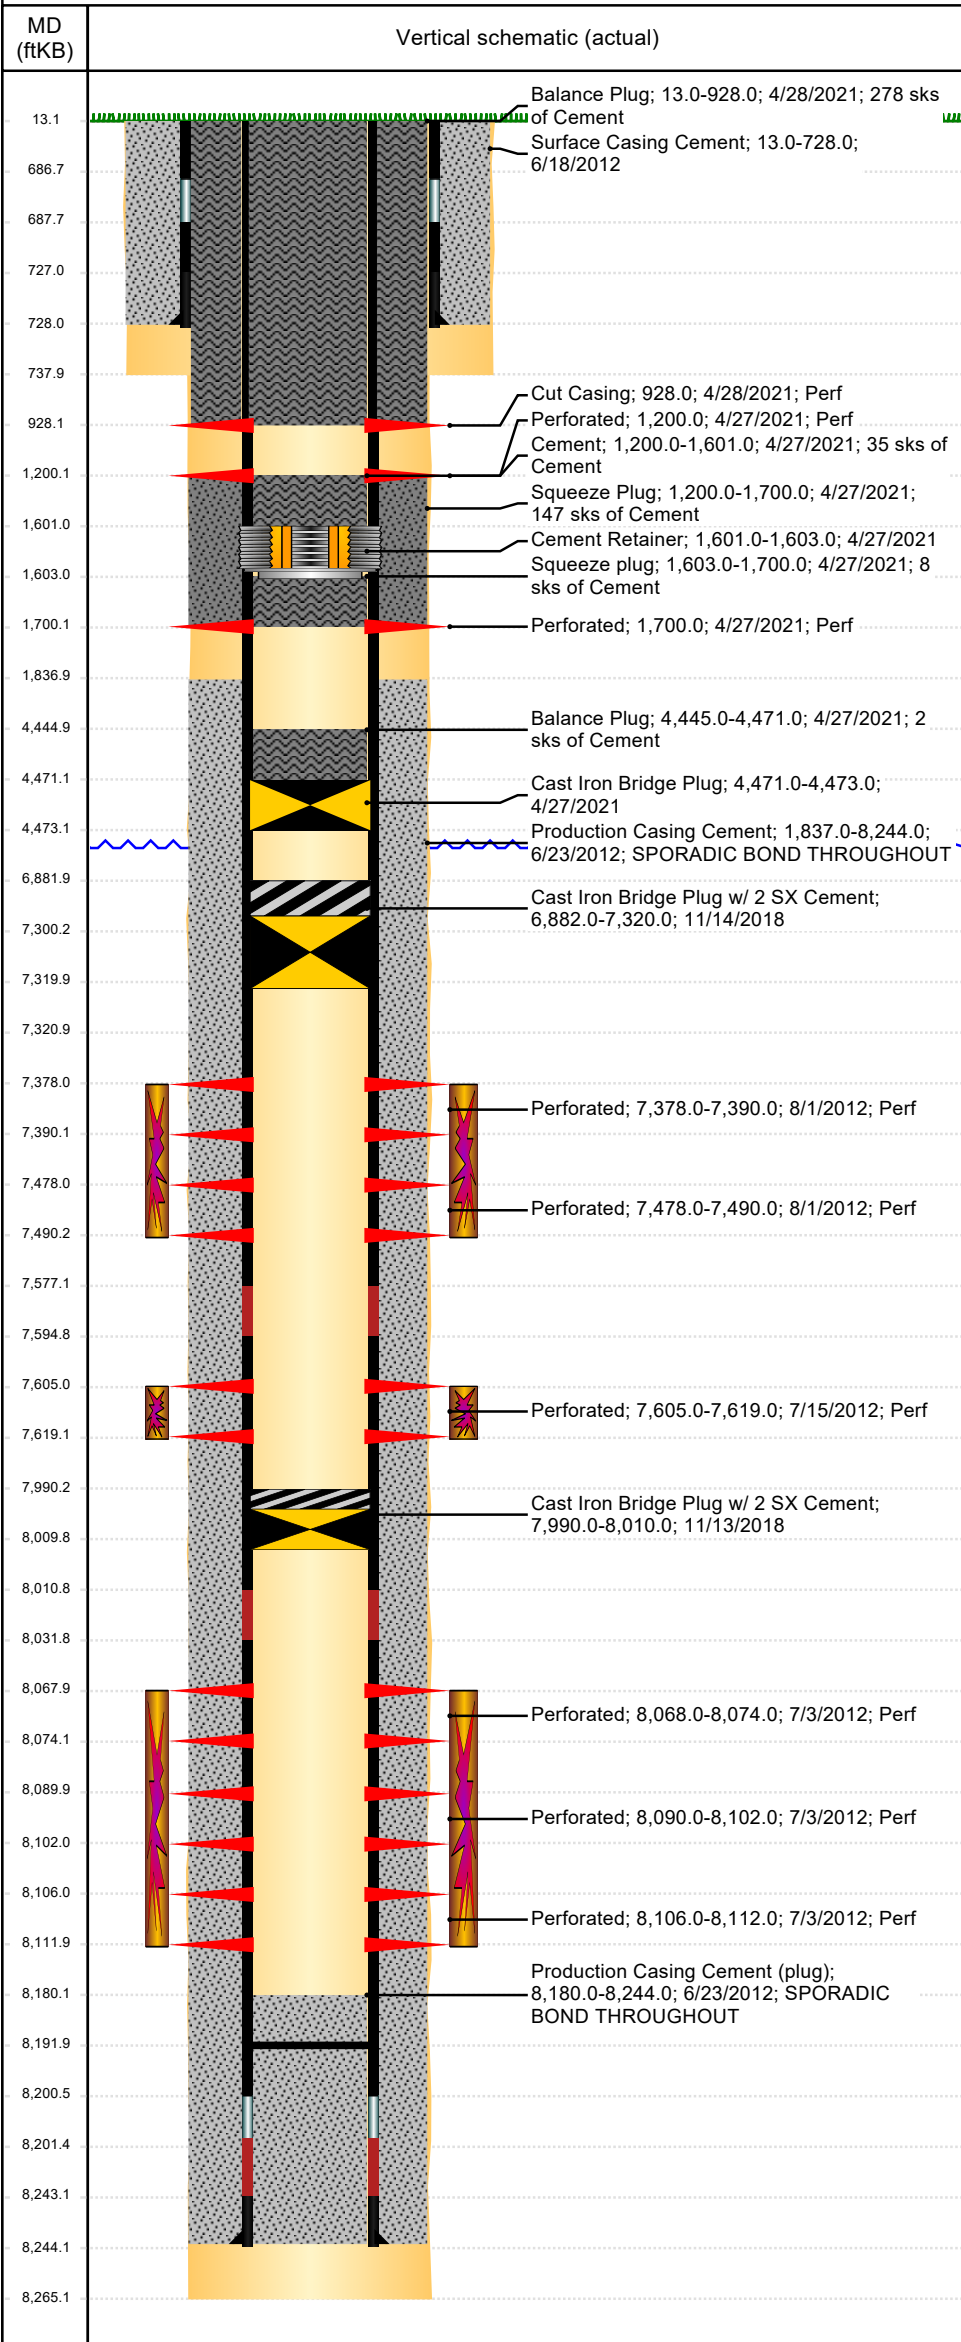

Well Header									
API 05-123-35582		Business Unit DJ BASIN			District 15		Well Configuration Type DEVIATED		
KB - GL / MSL (ftKB) 13.00		Spud Date 6/18/2012		P & A Date 6/10/2021		Well Production Status PA			SoRT Yes
Comment									
Surface Location (Congressional)									
Quarter 3 NE	Quarter 4 NW	Section 19	Township 3	Twnshp N N	Range 64	Rng E/W W	Actual Latitude (°) 40.21504524	Actual Longitude (°) -104.59713063	
Wellbore Sections									
Section Des			Size (in)		Act Top, MD (ftKB)		Act Btm, MD (ftKB)		
SURFACE			12 1/4		13		738		
PRODUCTION			7 7/8		738		8,265		
Casing Strings									
Csg Des			Run Date		OD (in)	Wt/Len (lb/ft)	Grade	Top, MD (ftKB)	MD (ftKB)
Surface			6/18/2012		8 5/8	24.00	J-55	13.0	728.0
PRODUCTION			6/22/2012		4 1/2	11.60	M-80	13.0	8,244.0
Cement									
Des					Start Date		Top (ftKB)		Btm (ftKB)
Surface Casing Cement					6/18/2012		13.0		728.0
Production Casing Cement					6/23/2012		1,837.0		8,244.0
Squeeze Plug					4/27/2021		1,200.0		1,700.0
					4/27/2021		1,200.0		1,601.0
Squeeze plug					4/27/2021		1,603.0		1,700.0
Balance Plug					4/27/2021		4,445.0		4,471.0
Balance Plug					4/28/2021		13.0		928.0
Zone Statuses									
Zone Name	Status Date	Status	Fluid Type	Job				Prod Method	
CODELL	11/13/2018	TA		PLUG AND ABANDON, 11/13/2018 06:00					
CODELL	4/27/2021	P&A							
NIOBRARA	11/13/2018	TA		PLUG AND ABANDON, 11/13/2018 06:00					
NIOBRARA	4/27/2021	P&A							
J SAND	11/13/2018	TA		PLUG AND ABANDON, 11/13/2018 06:00					
J SAND	4/27/2021	P&A							
Perforation Data									
Linked Zone	Bnch/Stg	Entered Shot Total	Top (ftKB)		Btm (ftKB)		Date		
	CUT CSG F		928.00		928.00		4/28/2021		
	SQZ HOLES		1,200.00		1,200.00		4/27/2021		
	SQZ HOLES		1,700.00		1,700.00		4/27/2021		
NIOBRARA, ORIGINAL HOLE	B	24	7,378.00		7,390.00		8/1/2012		
NIOBRARA, ORIGINAL HOLE	C	24	7,478.00		7,490.00		8/1/2012		
CODELL, ORIGINAL HOLE		56	7,605.00		7,619.00		7/15/2012		
J SAND, ORIGINAL HOLE		24	8,068.00		8,074.00		7/3/2012		
J SAND, ORIGINAL HOLE		48	8,090.00		8,102.00		7/3/2012		
J SAND, ORIGINAL HOLE		24	8,106.00		8,112.00		7/3/2012		
Stimulation Intervals									
Zone			Start Date		Top (ftKB)		Btm (ftKB)		
NIOBRARA, ORIGINAL HOLE			8/1/2012		7,378.0		7,490.0		
CODELL, ORIGINAL HOLE			8/1/2012		7,605.0		7,619.0		
J SAND, ORIGINAL HOLE			7/15/2012		8,068.0		8,112.0		
Other In Hole									
Run Date	Des				Make	OD (in)	Top (ftKB)	Btm (ftKB)	
11/13/2018	Cast Iron Bridge Plug w/ 2 SX Cement					3.99	7,990.0	8,010.0	
11/14/2018	Cast Iron Bridge Plug w/ 2 SX Cement					3.99	6,882.0	7,320.0	
4/27/2021	Cast Iron Bridge Plug					3.99	4,471.0	4,473.0	
4/27/2021	Cement Retainer					3.99	1,601.0	1,603.0	
Logs									
Date		Type				Top, MD (ftKB)		Btm, MD (ftKB)	
11/28/2011		MUD LOG				6,482.0		11,767.0	
6/22/2012		Caliper/Comp. Density/Neutron/GR/SP/ML				2,650.0		8,259.0	
6/22/2012		DIL/GR/SP/Caliper				728.0		8,259.0	
6/28/2012		CBL/CCL/GR				1,630.0		8,173.0	
6/12/2014		GYRO				13.0		7,950.0	



P&A Wellbore For State

Well Name: BUTTERBALL D19-17D

DEVIATED, ORIGINAL HOLE, 7/9/2021 11:08:47 AM

Plug Back Total Depths

