


T4S, R96W, 6th P.M.

- 1971 Brass Cap,
Flush W/Ground,
E-W Fence
Lat: 39.709845°
Long: 108.144580°

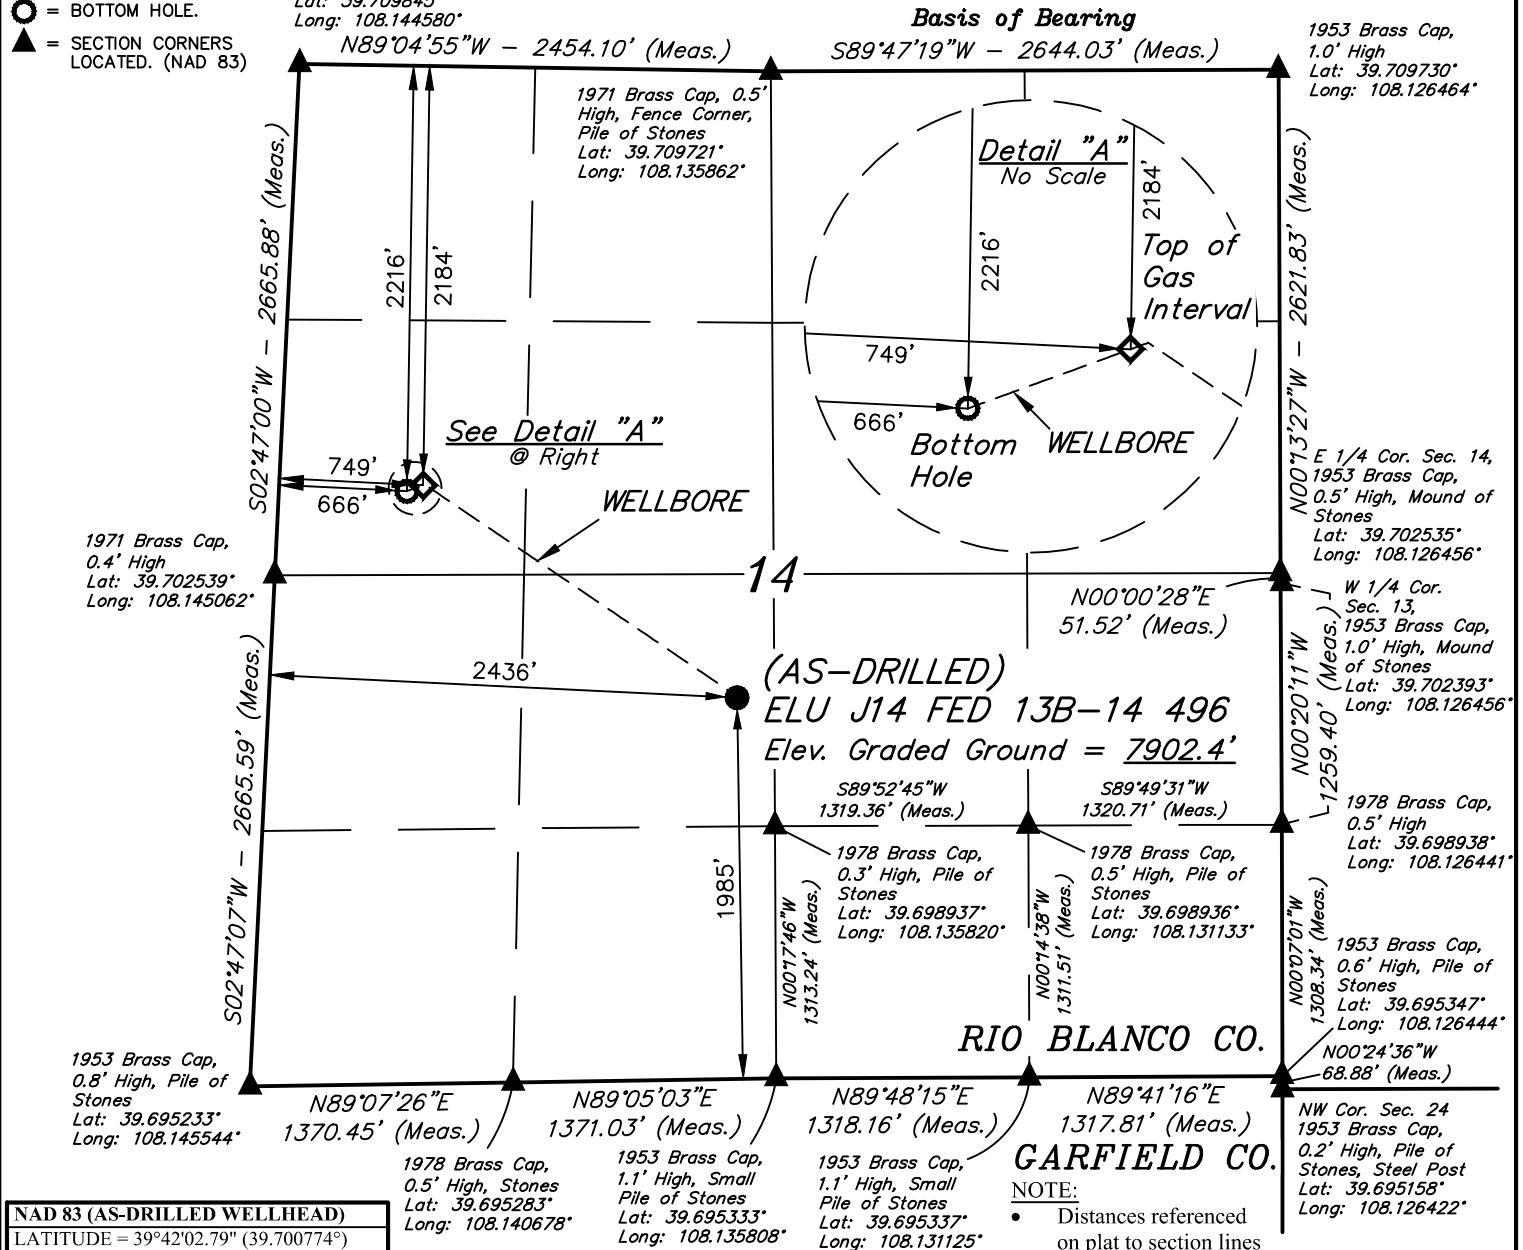

NAD 83 (AS-DRILLED WELLHEAD)
LATITUDE = 39°42'02.79" (39.700774°)
LONGITUDE = 108°08'11.46" (108.136515°)
NAD 27 (AS-DRILLED WELLHEAD)
LATITUDE = 39°42'02.87" (39.700799°)
LONGITUDE = 108°08'09.17" (108.135879°)
UTM NAD 27 (ZONE 12)
N: 14429966.89' E: 2446089.55'
NAD 83 (TOP OF GAS INTERVAL)
LATITUDE = 39°42'13.75" (39.703820°)
LONGITUDE = 108°08'32.33" (108.142313°)
NAD 27 (TOP OF GAS INTERVAL)
LATITUDE = 39°42'13.84" (39.703845°)
LONGITUDE = 108°08'30.04" (108.141677°)
UTM NAD 27 (ZONE 12)
N: 14431024.25' E: 2444423.10'

Lat: 39.695283° *File of Stones*
Long: 108.140678° *Lat: 39.695333°*
 Long: 108.13580°

1000'
 500'
 0'

NAD 83 (BOTTOM HOLE)
 LATITUDE = 39°42'13.45" (39.703736°)
 LONGITUDE = 108°08'33.41" (108.142615°)

NAD 27 (BOTTOM HOLE)
 LATITUDE = 39°42'13.54" (39.703761°)
 LONGITUDE = 108°08'31.12" (108.141978°)

UTM NAD 27 (ZONE 12)
 N: 14430990.97' E: 2444339.25'

PDOP = 1.5

BEARINGS ARE BASED ON THE ASSUMPTION THAT THE NORTH LINE OF THE
NORTHEAST 1/4 OF SECTION 14 BEARS S89°47'19"W. MONUMENTS DESCRIBED HEREON.

BENCH MARK (H79) LOCATED IN THE NE 1/4 OF SECTION 35, T4S, R98W, 6th P.M., TAKEN FROM THE BULL FORK QUADRANGLE, COLORADO, 7.5 MINUTE SERIES. (TOPOGRAPHIC MAP) PUBLISHED BY THE UNITED STATES DEPARTMENT OF THE INTERIOR, GEOLOGICAL SURVEY. SAID ELEVATION IS MARKED AS BEING 8535 FEET.



UELS, LLC
Corporate Office * 85 South 200 East
Vernal, UT 84078 * (435) 789-1017



**(AS-DRILLED) ELU J14 FED 13B-14 496
NE 1/4 SW 1/4, SECTION 14, T4S, R96W, 6th P.M.
RIO BLANCO COUNTY, COLORADO**

SURVEYED BY	JOHN FLOYD	11-12-20	SCALE
DRAWN BY	T.L.L.	01-20-21	1" = 1000'

(AS-DRILLED) WELL LOCATION PLAT