


WELL LOCATION CERTIFICATE

DOTSERO 5

SECTION 6, TOWNSHIP 7 NORTH, RANGE 64 WEST OF THE 6TH P.M.

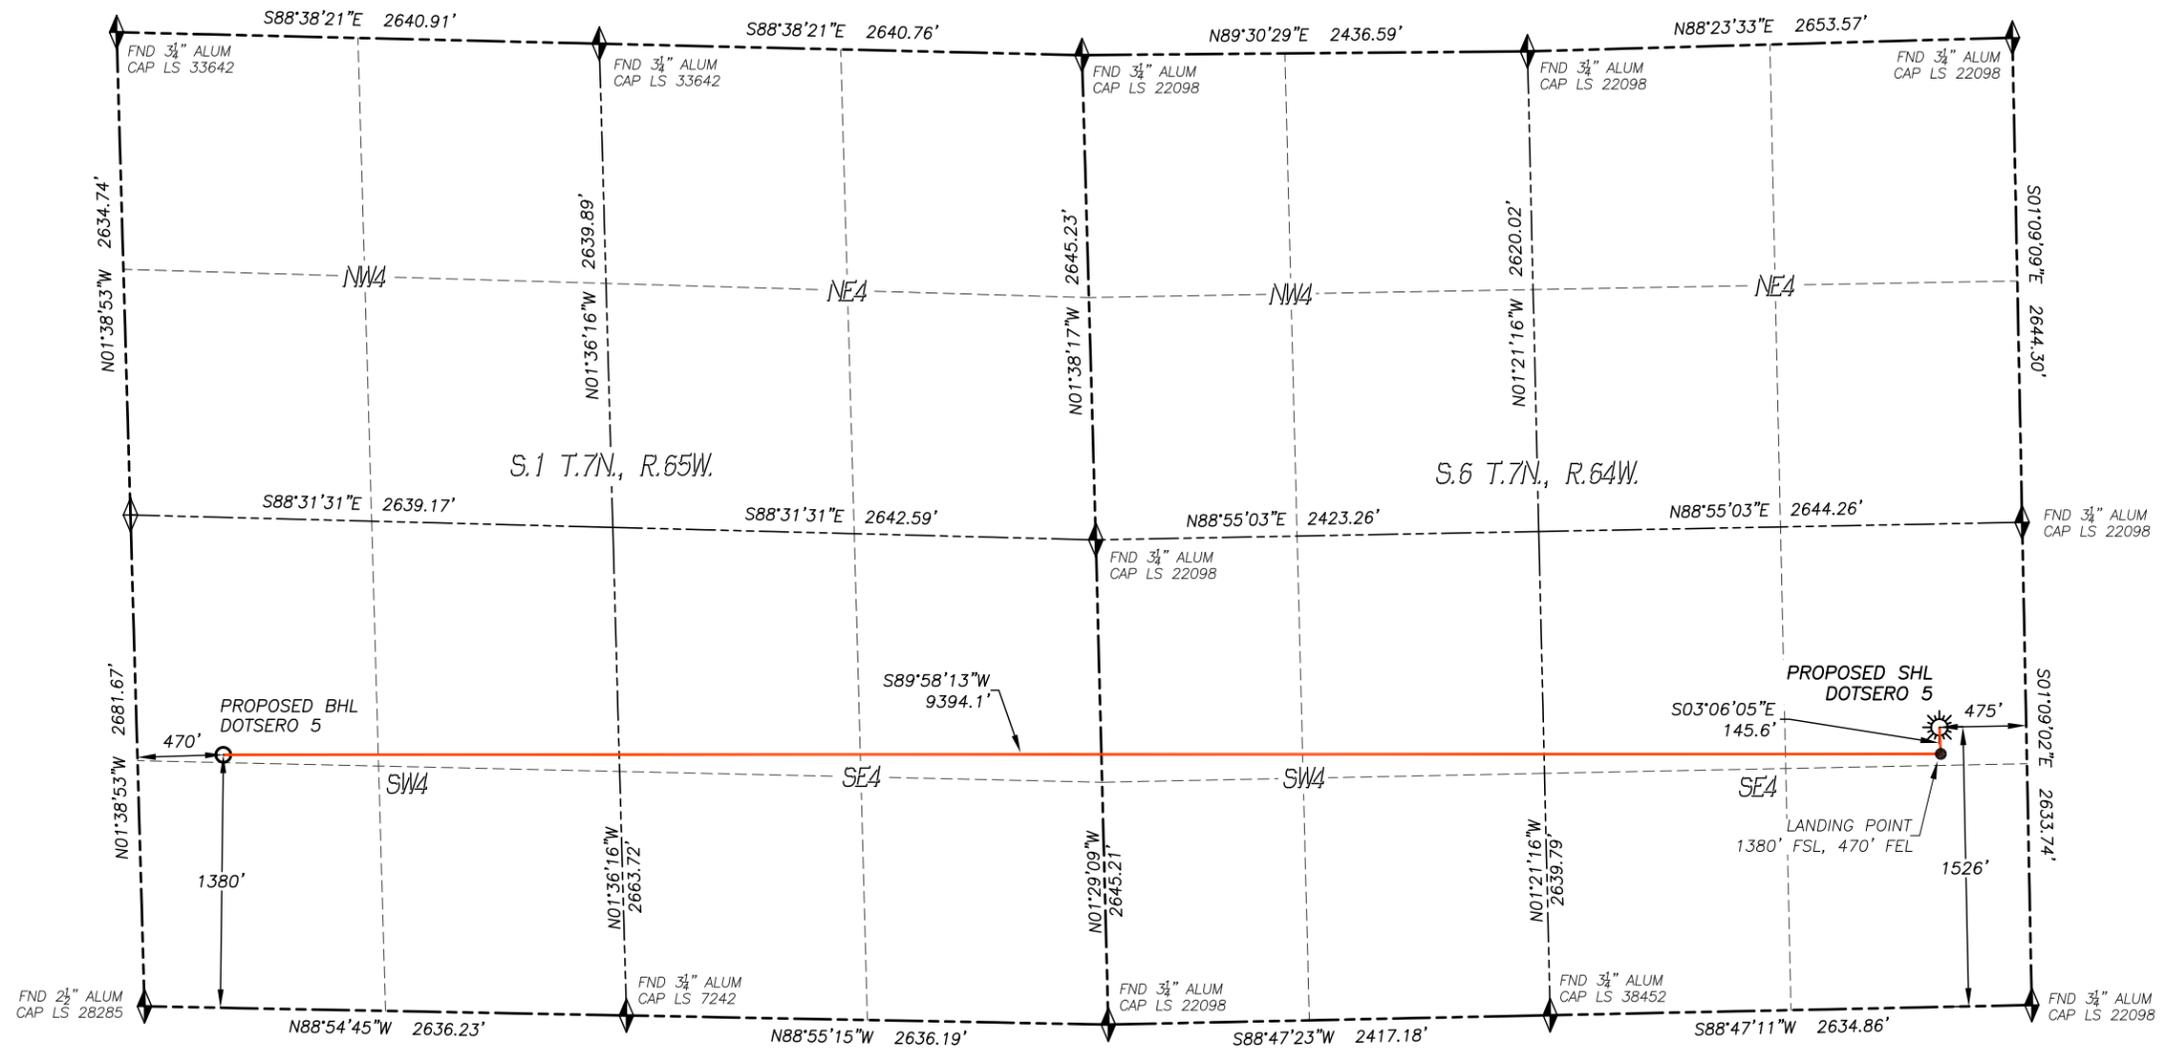

IN ACCORDANCE WITH A REQUEST FROM BAYSWATER EXPLORATION AND PRODUCTION LLC., DALEY LAND SURVEYING, INC. HAS DETERMINED THE SURFACE LOCATION OF THE DOTSERO 5 WELL TO BE 1526' FSL, 475' FEL, AS MEASURED AT NINETY (90) DEGREES FROM THE SECTION LINES OF SECTION 6, TOWNSHIP 7 NORTH, RANGE 64 WEST, AND THE BOTTOM HOLE LOCATION TO BE 1380' FSL, 470' FWL, AS MEASURED AT NINETY (90) DEGREES FROM THE SECTION LINES OF SECTION 1, TOWNSHIP 7 NORTH, RANGE 65 WEST, OF THE 6TH PRINCIPAL MERIDIAN, WELD COUNTY, COLORADO.

I HEREBY STATE THAT THIS WELL LOCATION CERTIFICATE WAS PREPARED BY ME OR UNDER MY DIRECT SUPERVISION, THAT THE WORK WAS COMPLETED ON 6/14/21 FOR AND ON BEHALF OF BAYSWATER EXPLORATION AND PRODUCTION LLC., AND THAT THIS MAP DOES NOT REPRESENT A BOUNDARY SURVEY, IT IS NOT A LAND SURVEY PLAT OR AN IMPROVEMENT SURVEY PLAT AND IT IS NOT TO BE RELIED UPON FOR THE ESTABLISHMENT OF FENCE, BUILDING OR OTHER FUTURE IMPROVEMENT LINES.

NOTES:

1. BEARINGS FOR THIS MAP ARE ASSUMED AND BASED UPON GPS OBSERVATIONS MADE BETWEEN MONUMENTS LOCATED AT THE NORTHEAST CORNER AND EAST QUARTER CORNER OF SECTION 6, T.7N., R.64W.
2. HORIZONTAL DATUM IS NAD83.
3. VERTICAL DATUM IS NAVD88 AND ORIGINATES FROM THE LOCAL C.O.R.S. NETWORK, UTILIZING THE GEOID12A MODEL.
4. SEE LOCATION DRAWING FOR VISIBLE IMPROVEMENTS WITHIN 500' OF PROPOSED DISTURBED AREA.
5. SURFACE USE: PASTURE/RANGELAND.
6. INST. OPERATOR: KYLE DALEY

NAD 83 LATITUDE AND LONGITUDE

SURFACE LOCATION:


LATITUDE: N40.59883°
 LONGITUDE: W104.58455°
 ELEV.: 4989'
 PDOP.: 1.1
 QTR/QTR: NE4/SE4

LANDING POINT:

LATITUDE: N40.59843°
 LONGITUDE: W104.58453°
BOTTOM HOLE:
 LATITUDE: N40.59868°
 LONGITUDE: W104.61834°

LEGEND

- ◆ FOUND MONUMENT AS DESCRIBED
- ◻ CALCULATED POSITION
- ☀ PROPOSED WELL
- ⊙ EXISTING WELL
- BOTTOM HOLE

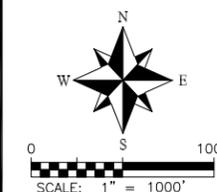

NEAREST CULTURAL ITEMS:

BUILDING:	3612'± SE
BUILDING UNIT:	3581'± SE
HIGH OCC. BLD. UNIT:	5280'+
DES. OUTSIDE ACTIVITY AREA:	5280'+
PUBLIC ROAD:	465'± E
ABOVE GROUND UTILITY:	449'± E
RAILROAD:	5280'+
PROPERTY LINE:	475'± E
SCHOOL FACILITY:	5280'+
SCHOOL PROPERTY LINE:	5280'+
CHILDCARE FACILITY:	5280'+



FOR AND ON BEHALF OF
 DALEY LAND SURVEYING INC.,
 Robert Daley, PLS 35597

