

COORDINATE TABLE



ABBREVIATIONS LEGEND:


SURFACE HOLE LOCATION	(SHL)
LANDING POINT LOCATION	(LP)
TOP OF PRODUCTION ZONE	(TPZ)
BOTTOM OF PRODUCTION ZONE	(BPZ)
BOTTOM HOLE LOCATION	(BHL)
LATITUDE NAD 83	(LAT.83)
LONGITUDE NAD 83	(LONG.83)
LATITUDE NAD 27	(LAT.27)
LONGITUDE NAD 27	(LONG.27)
COLORADO COORDINATE SYSTEM OF 1983 NORTH ZONE	(SPC83)
COLORADO COORDINATE SYSTEM OF 1927 NORTH ZONE	(SPC27)

Note:

1. All (SPC83) and (SPC27) coordinate values are U.S. Survey Feet.
2. All Latitude and Longitude values are decimal degrees.

SCHNEIDER 1414-05H

	(LAT.83)	(LONG.83)	NORTHING EASTING		(LAT.27)	(LONG.27)	NORTHING EASTING	
			(SPC83)	(SPC83)			(SPC27)	(SPC27)
(SHL)	N40.6691031	W104.0623220	1489830.00	3398801.29	N40.6691165	W104.0618174	489828.61	2398951.81
(TPZ)	N40.6690003	W104.0516613	1489840.66	3401758.82	N40.6690135	W104.0511567	489839.23	2401909.43
(BPZ)	N40.6560817	W104.0519733	1485133.38	3401749.14	N40.6560950	W104.0514686	485132.03	2401899.82
(BHL)	N40.6558347	W104.0519793	1485043.35	3401748.95	N40.6558479	W104.0514745	485042.00	2401899.63

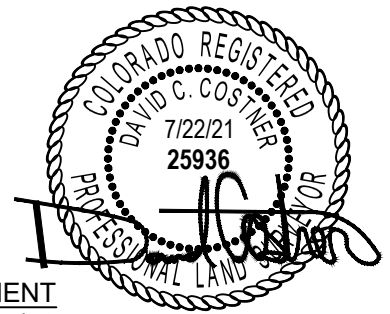

SURVEYOR'S STATEMENT

The undersigned hereby states that the well location shown hereon was staked on the ground based on existing monumentation and/or physical evidence found in the field and is correct to the best of my knowledge, information and belief.



VERDAD RESOURCES
SCHNEIDER 1414-05H
JOB NO. 117800

JLS	06/11/2018	REVISION:	
SHEET :	2 OF 2	INT	DATE
FILE:LO_SCHNEIDER_1414_05H_REV0	PAV	07/22/2021	