Equity Oil & Gas
Emerald C 138
API # 103-05392

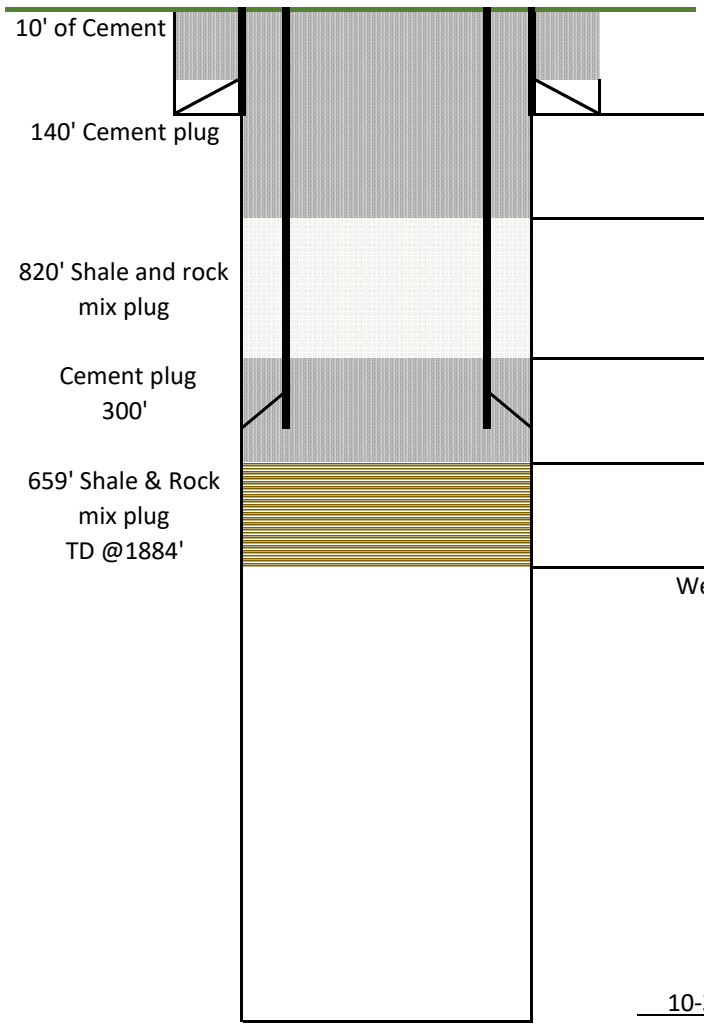

10-3/4" Csg set @ 45' from surface

Class ASTM C Cement
144' to 4' from surface
75 Sacks

Shale & rock plug
964' to 144'
7" - 20# casing set to 1214'RKB

Class ASTM C Cement
1264' to 964'
Approx: 140-145 Sacks

Shale and Rock plug 1884' to 1264'

Well maybe bridged off @1884'

10-3/4" Surface, 7" 20# Cased hole & Open hole to 4408'