


# Site Map

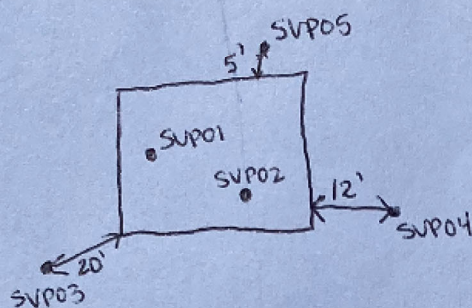

## Site Information

Site	Schmid 2-34
Date	4/23/21
Sampler Name	Mary Kiel
GEM 5000	6451

## GEM Calibrations

Calibration Gas	Time
Pure N2	1302
Fresh Air	1304
50 ppm CO, 10 ppm H2S	1306
15% CH4, 15% CO2, Bal N2	1309

## Bump Test

Time		CH4 (%)	CO2 (%)	O2 (%)	H2S (PPM)	CO (PPM)
1310	Calibration Gas	15.0	15.0	0.0	0	0
	Readings	14.9	14.9	0.1	0	0

## GEM Field Readings

Well	CH4 (%)	CO2 (%)	O2 (%)	H2S (PPM)	CO (PPM)	Time	Comments
SVPO1	0.0	0.1	20.3	0	0	1315	
SVPO2	0.0	0.1	20.1	0	0	1317	
SVPO3	0.0	0.9	19.1	0	0	1324	
SVPO4	0.0	0.8	19.7	0	0	1327	
SVPO5	0.0	1.2	19.0	0	0	1329	

Site Notes and Observations (Surrounding vegetation, stressed or lack of vegetation, etc.)

ag land mtted from excavation traffic