







**WELLBORE DIAGRAM**


| Well / Battery   | Prospect Name | Total Depth       | Current Status |
|------------------|---------------|-------------------|----------------|
| Helling 34-35444 | Bonny         | 1893              | SI             |
| Location         | Sec-Twn-Rng   | Producing Horizon | County & State |

**WELLBORE DIAGRAM**

Prepared Date:         
 Prepared By:       

**General Info**

API #: 05-125-08367  
 KB Elevation:         
 GL Elevation: 3888'  
 Spud Date: 9/16/2001  
 Completion Date: 10/12/2001  
 TVD: 1893'  
 MD: 1893'  
 Last PBTD: 1825'

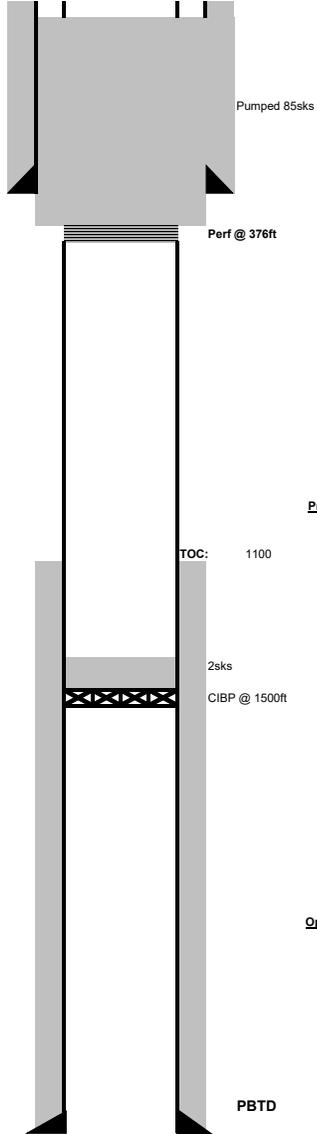

**CONDUCTOR CSG**

Pumped 85sks

**Surface Casing**

7 inch (OD)  
 16 # (weight)  
 grade  
 326 depth from KB  
 0 cement top Visual Returns  
 150 sacks of cement  
 9 7/8 inch (OD) HOLE SIZE

**Production Casing**

4 1/2 inch (OD)  
 10.5 # (weight)  
 grade  
 1866 depth from KB  
 1100 cement top  
 75 sacks of cement  
 6 1/4 inch (OD) HOLE SIZE

Calculated

**Open Perforations**