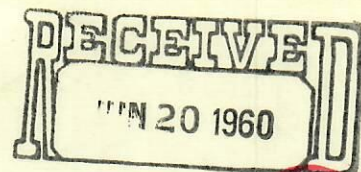


OIL AND GAS CONSERVATION COMMISSION  
OF THE STATE OF COLORADOOIL & GAS  
CONSERVATION COMMISSION

00238464


## NOTICE OF INTENTION TO DRILL

## INSTRUCTIONS:

A notice of intention to drill a well shall be filed in duplicate on all Federal and Patented lands, and in triplicate on all State lands. Do not begin operations until approved copy has been received. It is mandatory that the proposed location comply with all rules and regulations of the Commission. Locate well on section grid in proper location, and indicate extent of lease. Unless operations are commenced within 180 days after the date of approval hereof, this approval to drill will become null and void.

Name of Operator B.F. ALLISON Phone No. TA 5-0158  
Address 218 PATTERSON BLDG City \_\_\_\_\_ State \_\_\_\_\_

How is liability secured: Well Bond (Attached) ☐; Blanket Bond ☐; Waiver ☒  
(Check one)

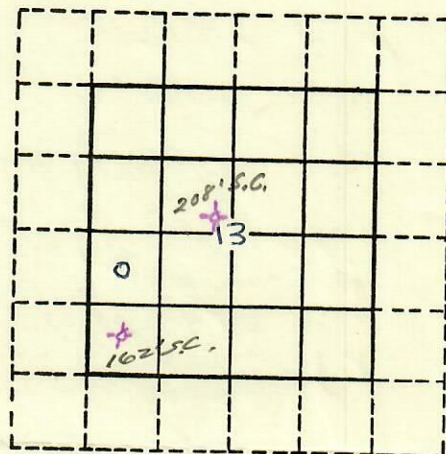Lease Name BOLLISH- RAMEYWell No. 1Field Name \_\_\_\_\_ Wildcat ☒County LOGAN

Location C NW-SW (quarter quarter) Section 13 Township 9N Range S3W Meridian 6th PM  
1980 feet from S Section line and 660 feet from W Section Line  
Nor S Nor W

The well is located on: Patented land ☒ State land ☐ Federal land ☐

The well is located within a spaced area: Yes ☐ No ☒

Distance from proposed location to nearest property or lease line 660 feet.  
Distance from proposed location to nearest drilling unit line \_\_\_\_\_ feet.

Objectives: "J" SAND Depth 4850 ; \_\_\_\_\_  
Formation Estimate Formation Depth Estimate

Proposed length of surface casing 130 feet.

REMARKS:

Agent	<u>W. H. HARRIS</u>
Bond	<u>waived</u>
Spot	
600 ft.	<input checked="" type="checkbox"/>
1200 ft.	<input checked="" type="checkbox"/>
Wells	
Oil	
Gas	
Status	

I/We hereby swear (or affirm) that the statements herein made are a full and correct report.

APPROVED:

Date June 20 1960

Director

Company B.F. ALLISON Date 6-17-60Address 218 PATTERSON BLDG Phone No. TA5-0158By Dale Thayer Title Agent

Signature