




RECEIVED

APR 30 1976

COLO. OIL & GAS CONS. COMM.

R. 53W

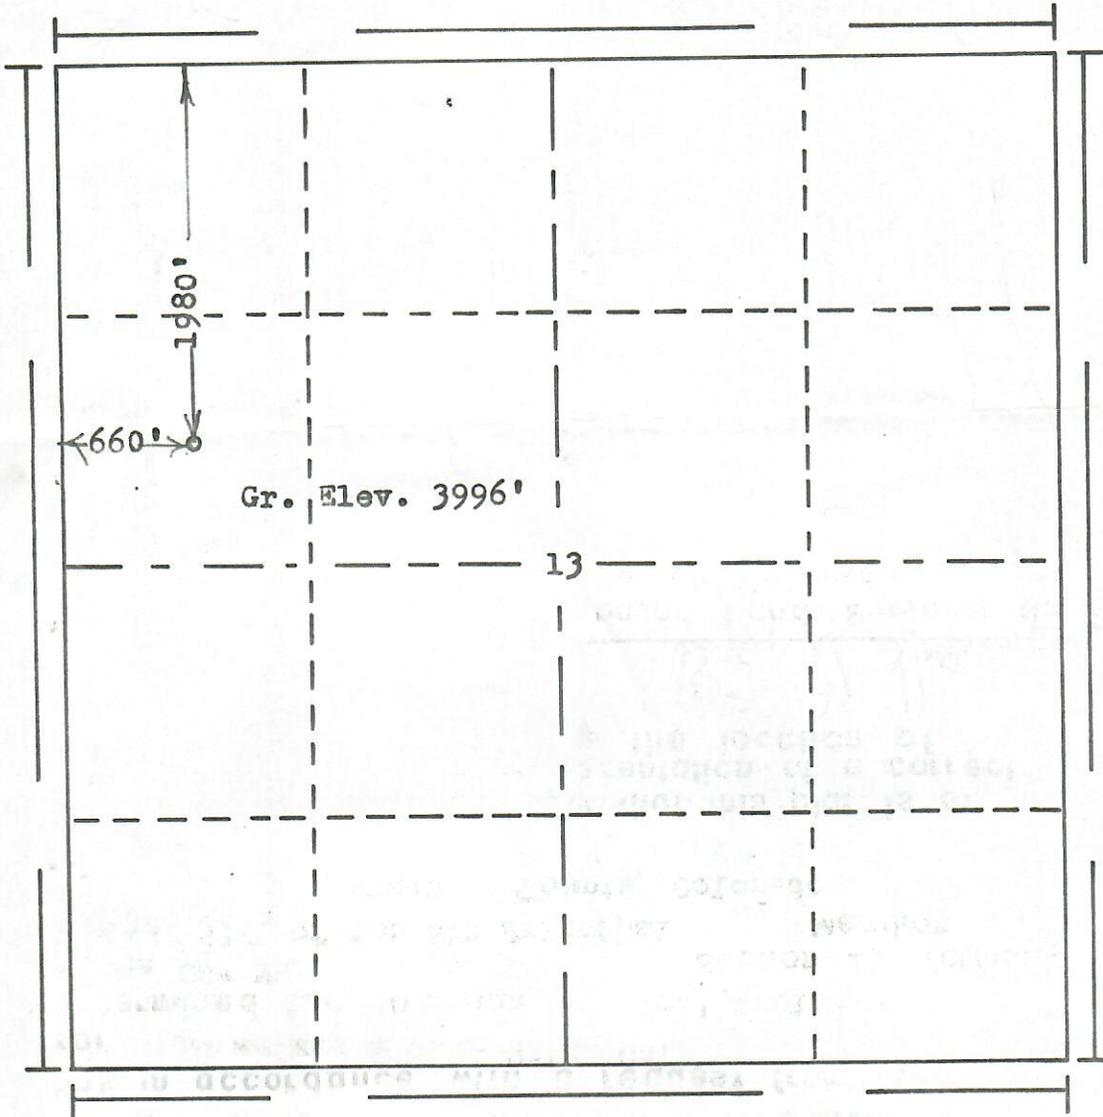

Scale... 1" = 1000'

Powers Elevation Company, Inc. of Denver, Colorado
 has in accordance with a request from Mr. Gear
 for W.L. Walker & Gear Drlg. Co.

determined the location of No.1 Croissant
 to be CSW NW Section 13 Township 9N
 Range 53W of the 6th Principal Meridian
Logan County, Colorado

76-106

I hereby certify that this plat is an
 accurate representation of a correct
 survey showing the location of

Date: 2-14-76

Billy D. Hallaway
 Licensed Land Surveyor/No. 2853
 State of Colorado

5-21-76
21.8/76