



00238452

OIL AND GAS CONSERVATION COMMISSION OF THE STATE OF COLORADO

RECEIVED
 MAR 14 1963

NOTICE OF INTENTION TO DRILL

 OIL & GAS
 CONSERVATION COMMISSION

INSTRUCTIONS:


A notice of intention to drill a well shall be filed in duplicate on all Federal and Patented lands, and in triplicate on all State lands. Do not begin operations until approved copy has been received. It is mandatory that the proposed location comply with all rules and regulations of the Commission. Locate well on section grid in proper location, and indicate extent of lease. Unless operations are commenced within 180 days after the date of approval hereof, this approval to drill will become null and void.

(James C. Hayes)

Name of Operator Winslow, Hayes, and Fundamental Oil Corp Phone No. Ma 3-6947
 Address 615 Colorado Bldg City Denver 2 State Colorado

How is liability secured: Well Bond (Attached) ☒; Blanket Bond ☐; Waiver ☐
 (Check one)

Lease Name Ramey-Croissant
 Well No. 1
 Field Name Chess ☒ Wildcat ☐
 County Logan

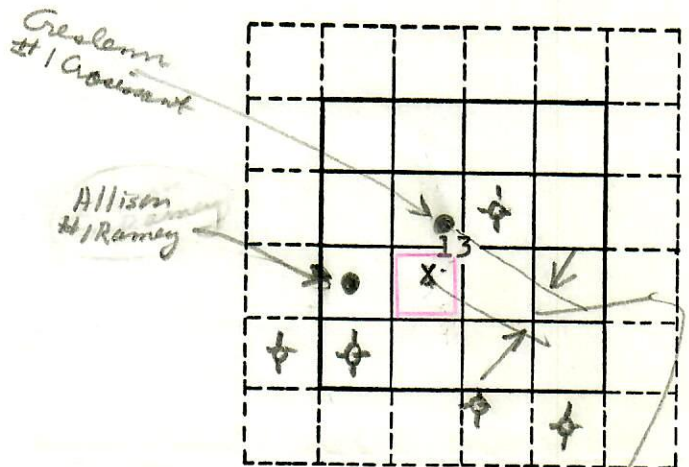

Location E NE SW Section 13 Township 9 N Range 53 W Meridian 6
2085 (quarter quarter) 1900
1980 feet from south Section line and 1980 feet from west Section Line
 N or S E or W

The well is located on: Patented land ☒ State land ☐ Federal land ☐

The well is located within a spaced area: Yes ☐ No ☒

Distance from proposed location to nearest property or lease line 660 feet.
 Distance from proposed location to nearest drilling unit line 660 feet.

Objectives: "J" sand Depth 4750; Skull Creek Sh Depth 4873
 Formation Estimate Formation Estimate

Proposed length of surface casing 150 est. feet.

REMARKS: Winslow and Hayes are operators.

Bunce Brown with Crescent gave approval for location. Will send in letter.

DVR 3/14/63

Agent	<input checked="" type="checkbox"/>
Bond	<i>attached</i>
Spot	<i>Plotted 3/14/63</i>
600 ft.	<input checked="" type="checkbox"/>
1200 ft.	<i>waived by Crescent</i>
Wells	
Oil	
Gas	
Status	

I/We hereby swear (or affirm) that the statements herein made are a full and correct report.

APPROVED:

Date MAR 14 1963

[Signature]
 Director

Company Winslow and Hayes ⁹⁷⁰⁶⁰ Date 3/13/63

Address 615 Colorado Bldg. Denver Phone No. Ma 3-6947

By *[Signature]* Title Owner
 James C. Hayes