

64-138

OGCC FORM 2



00238448

RECEIVED

APR - 8 1964

OIL AND GAS CONSERVATION COMMISSION OF THE STATE OF COLORADO

NOTICE OF INTENTION TO ~~DRILL~~ RE-ENTER ~~CONSERVATION COMMISSION~~

*Re-Enter*

INSTRUCTIONS:


A notice of intention to drill a well shall be filed in duplicate on all Federal and Patented lands, and in triplicate on all State lands. Do not begin operations until approved copy has been received. It is mandatory that the proposed location comply with all rules and regulations of the Commission. Locate well on section grid in proper location, and indicate extent of lease. Unless operations are commenced within 180 days after the date of approval hereof, this approval to drill will become null and void.

Name of Operator Comanche Oil Co. Phone No. 303-522-1839  
Address Box 30 City Sterling State Colorado

How is liability secured:  Well Bond (Attached)  Blanket Bond  Waiver   
(Check one)

Lease Name Ramey-Croissant\*  
Well No. 2  
Field Name Chess  Wildcat   
County Logan

*CREOLENN  
WINSLOW  
MAY 1963  
TO WINSLOW  
& HAYES*

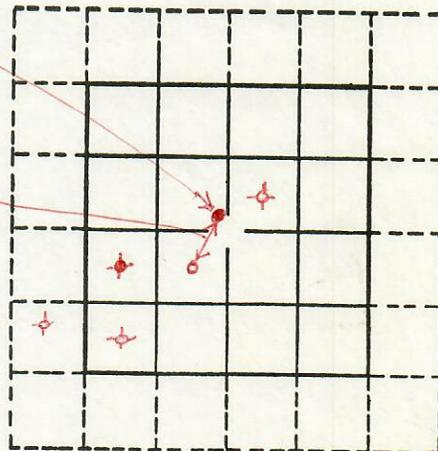

Location NE SW Section 13 Township 9N Range 53W Meridian S  
(quarter quarter)  
2085 feet from S Section line and 1900 feet from W Section Line  
N or S E or W

The well is located on: Patented land  State land  Federal land

The well is located within a spaced area: Yes  No

Distance from proposed location to nearest property or lease line 650 feet.  
Distance from proposed location to nearest drilling unit line \_\_\_\_\_ feet.

Objectives: J Formation Depth 4840 Estimate; \_\_\_\_\_ Formation Depth \_\_\_\_\_ Estimate

Proposed length of surface casing 80\* feet.

REMARKS:

This constitutes a re-entry into a dry abandoned well, known as Winslow, Hayes, Ramey - Croissant #1.

Agent	<input checked="" type="checkbox"/>
Band	<u>WASBY WAINED</u>
Spot	<u>Plotted 7/8/64</u>
600 ft.	<input checked="" type="checkbox"/>
1200 ft.	<u>was not</u>
Wells	<u>previous</u>
Oil	
Gas	
Status	

I/We hereby swear (or affirm) that the statements herein made are a full and correct report.

APPROVED:

Date APR 8 1964  
W. Rogers  
Director

Company Comanche Oil Co. <sup>18900</sup> Date 4-6-64  
Address Box 30 Phone No. 522-1839  
By J.H. Walsh Title \_\_\_\_\_  
Signature