

Final Reclamation Inspection

August 4, 2021

Operator: PDC ENERGY INC - 69175

Location ID: 327580

Inspection Document #: 701900021

Weld County, CO

NESE Section 21 T6N R66W

Corey McDonough
Reclamation Contractor, COGCC



COLORADO

**Oil & Gas Conservation
Commission**

Department of Natural Resources

Inspection Photos
Location Name: BILLINGS 43, 44-21
Location ID: 327580

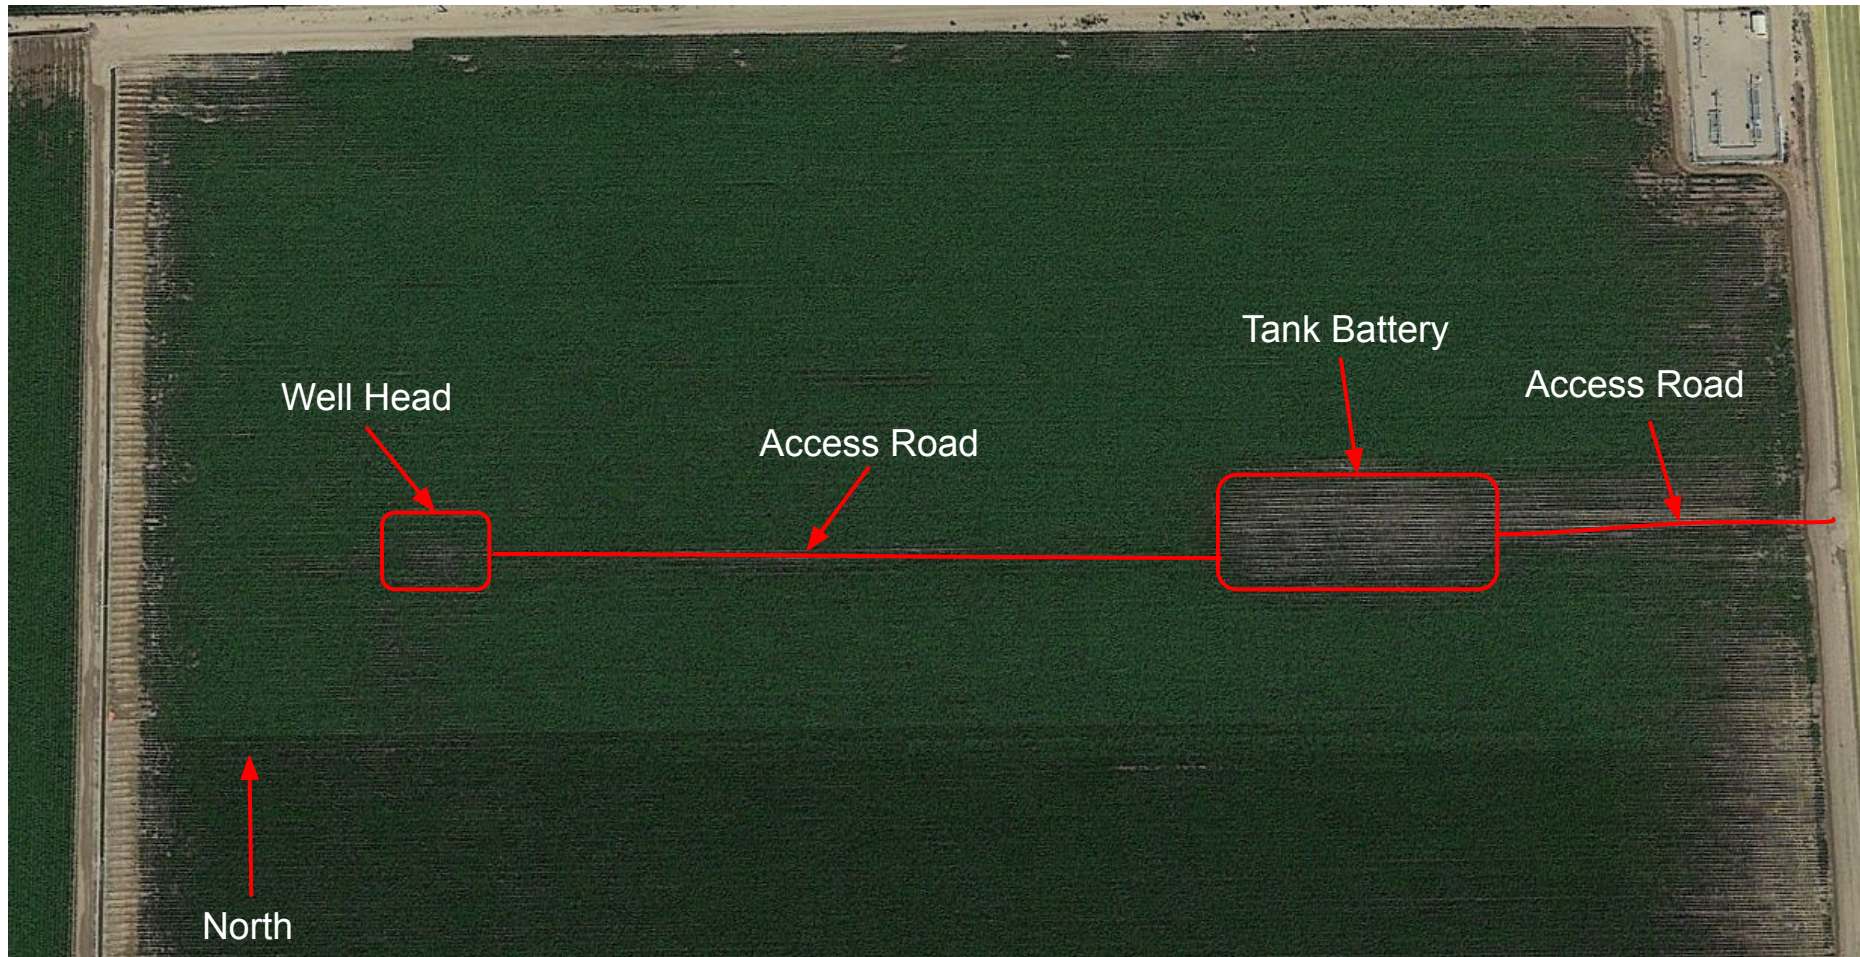


Photo 1. 2019 aerial imagery shows the well location, access roads, and associated tank battery.

Inspection Photos
Location Name: BILLINGS 43, 44-21
Location ID: 327580

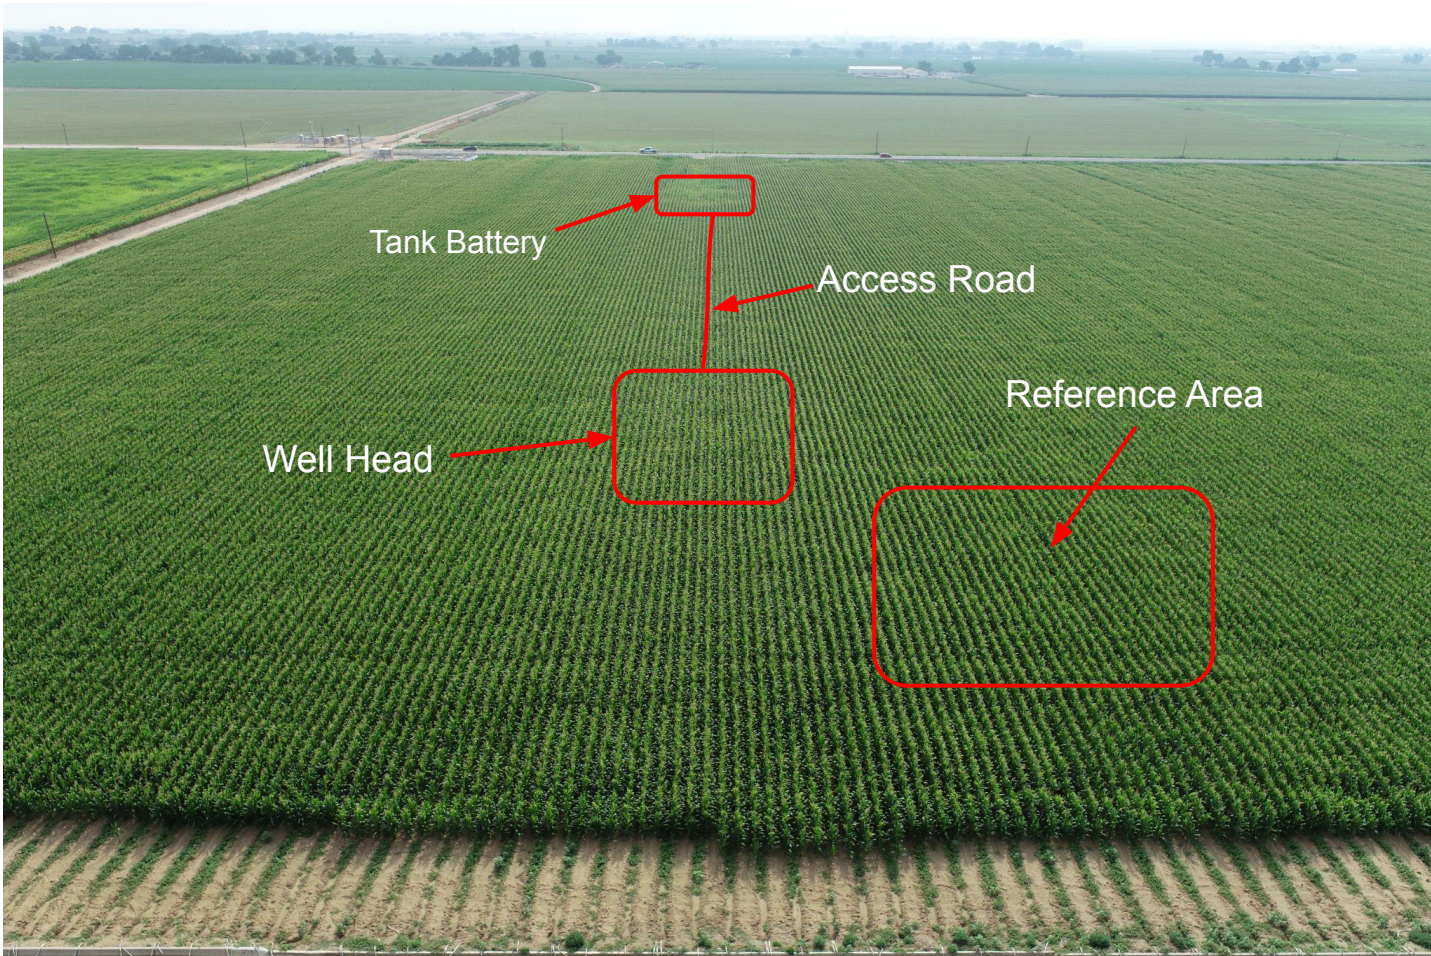



Photo 2. Overview photo of tank battery, well head, access road and reference area taken from west side of well head using a drone (north is left). Photo shows that the well location and associated access road appear to meet final reclamation and is reflective of adjacent reference area.

Inspection Photos
Location Name: BILLINGS 43, 44-21
Location ID: 327580



Photo 3. Overview photo taken of tank battery, access road, and reference area from west side of tank battery using a drone (north is left). See photo 4 for stunted growth model.

Inspection Photos
Location Name: BILLINGS 43, 44-21
Location ID: 327580

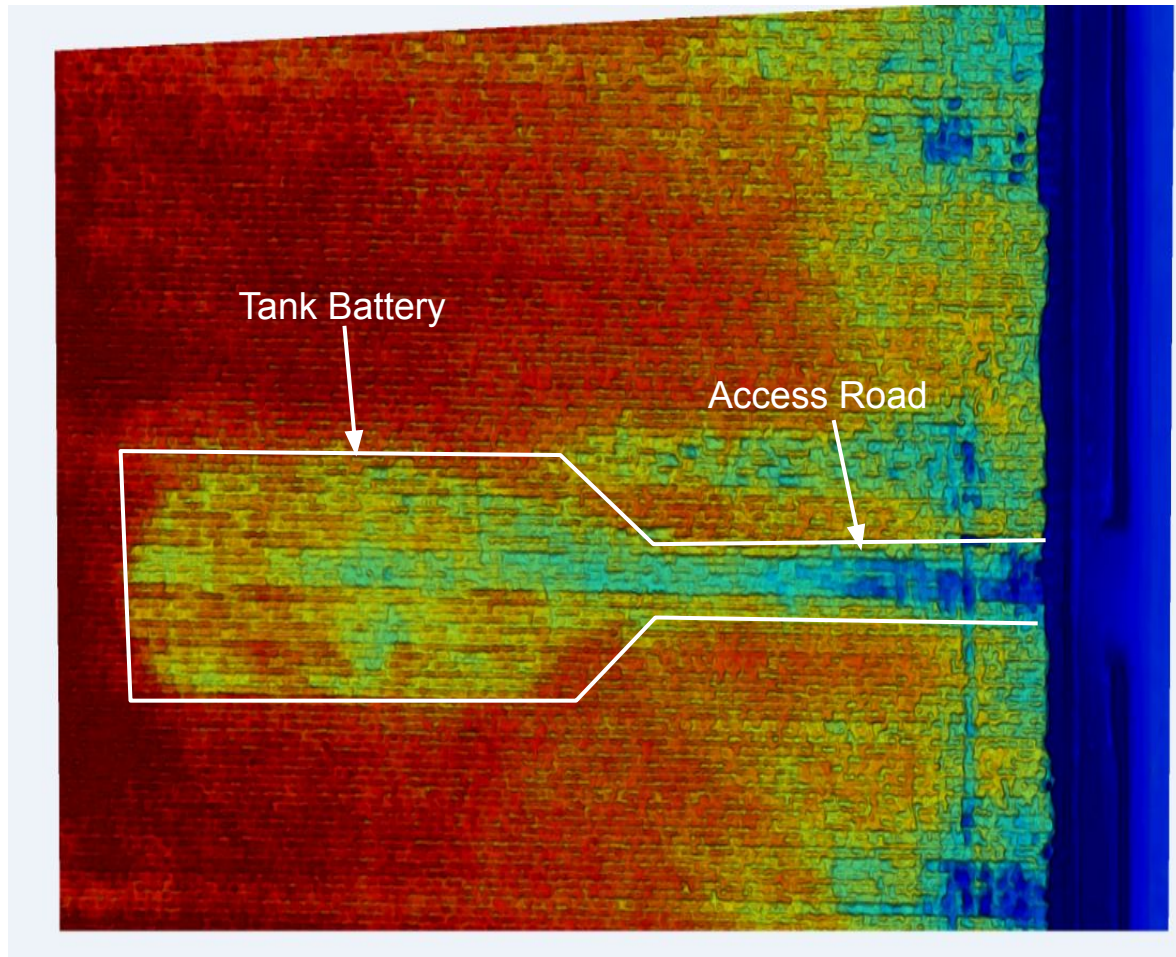

2019 overview aerial imagery



Photo 4. Overview photo shows crop heights at the tank battery and associated access road using a drone (up is north). Blue/green indicates crop heights at 2-4 feet, yellow/orange indicates crop heights at 5-6 feet and red indicates crop heights at 7-8 feet. Model shows stunted growth with average heights of 3-4 feet appear throughout a majority of the access road while heights at 5-6 feet dominate most of the tank battery. See photo 5 for crop height reference.

Inspection Photos
Location Name: BILLINGS 43, 44-21
Location ID: 327580

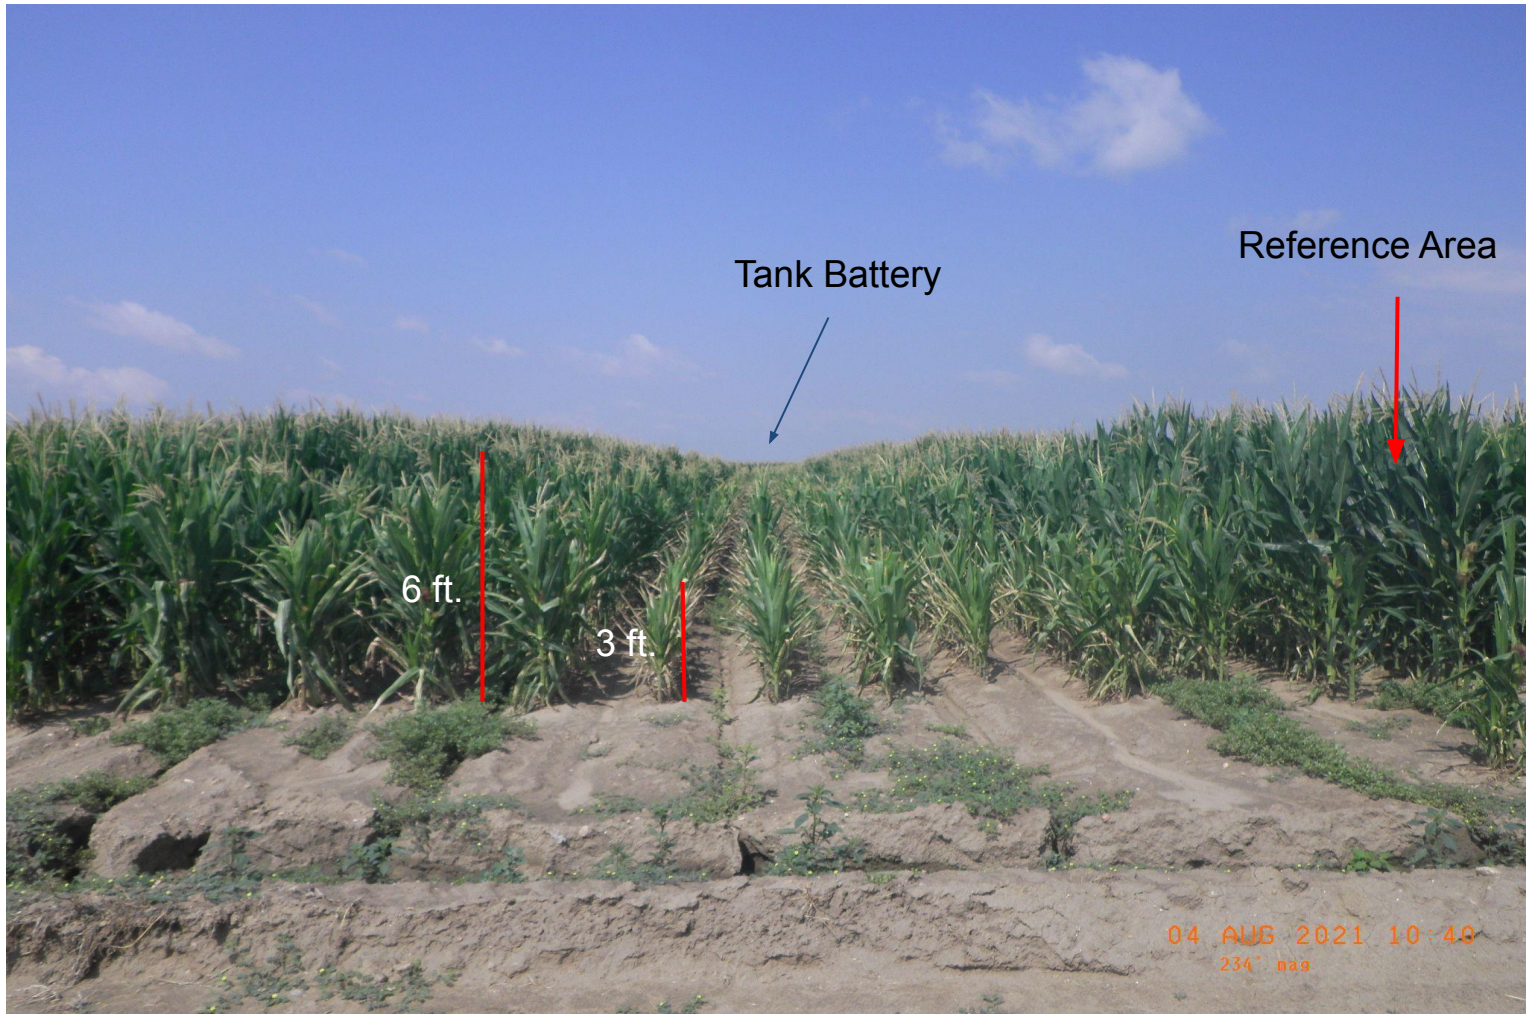


Photo 5. Photo at ground level taken from east side of tank battery looking west down access road. Photo shows crop growth along access road is not reflective of adjacent reference area.