

Taproot Rockies Midstream LLC

Hale Produced Water Release  
Briggsdale, CO  
Facility ID 467382

Legend

Hale Produced Water Line


Boundary of Shallow Excavation

Extent of Primary Excavation

Bottom of Excavation

Borrow Pit

Soil Sampling Location

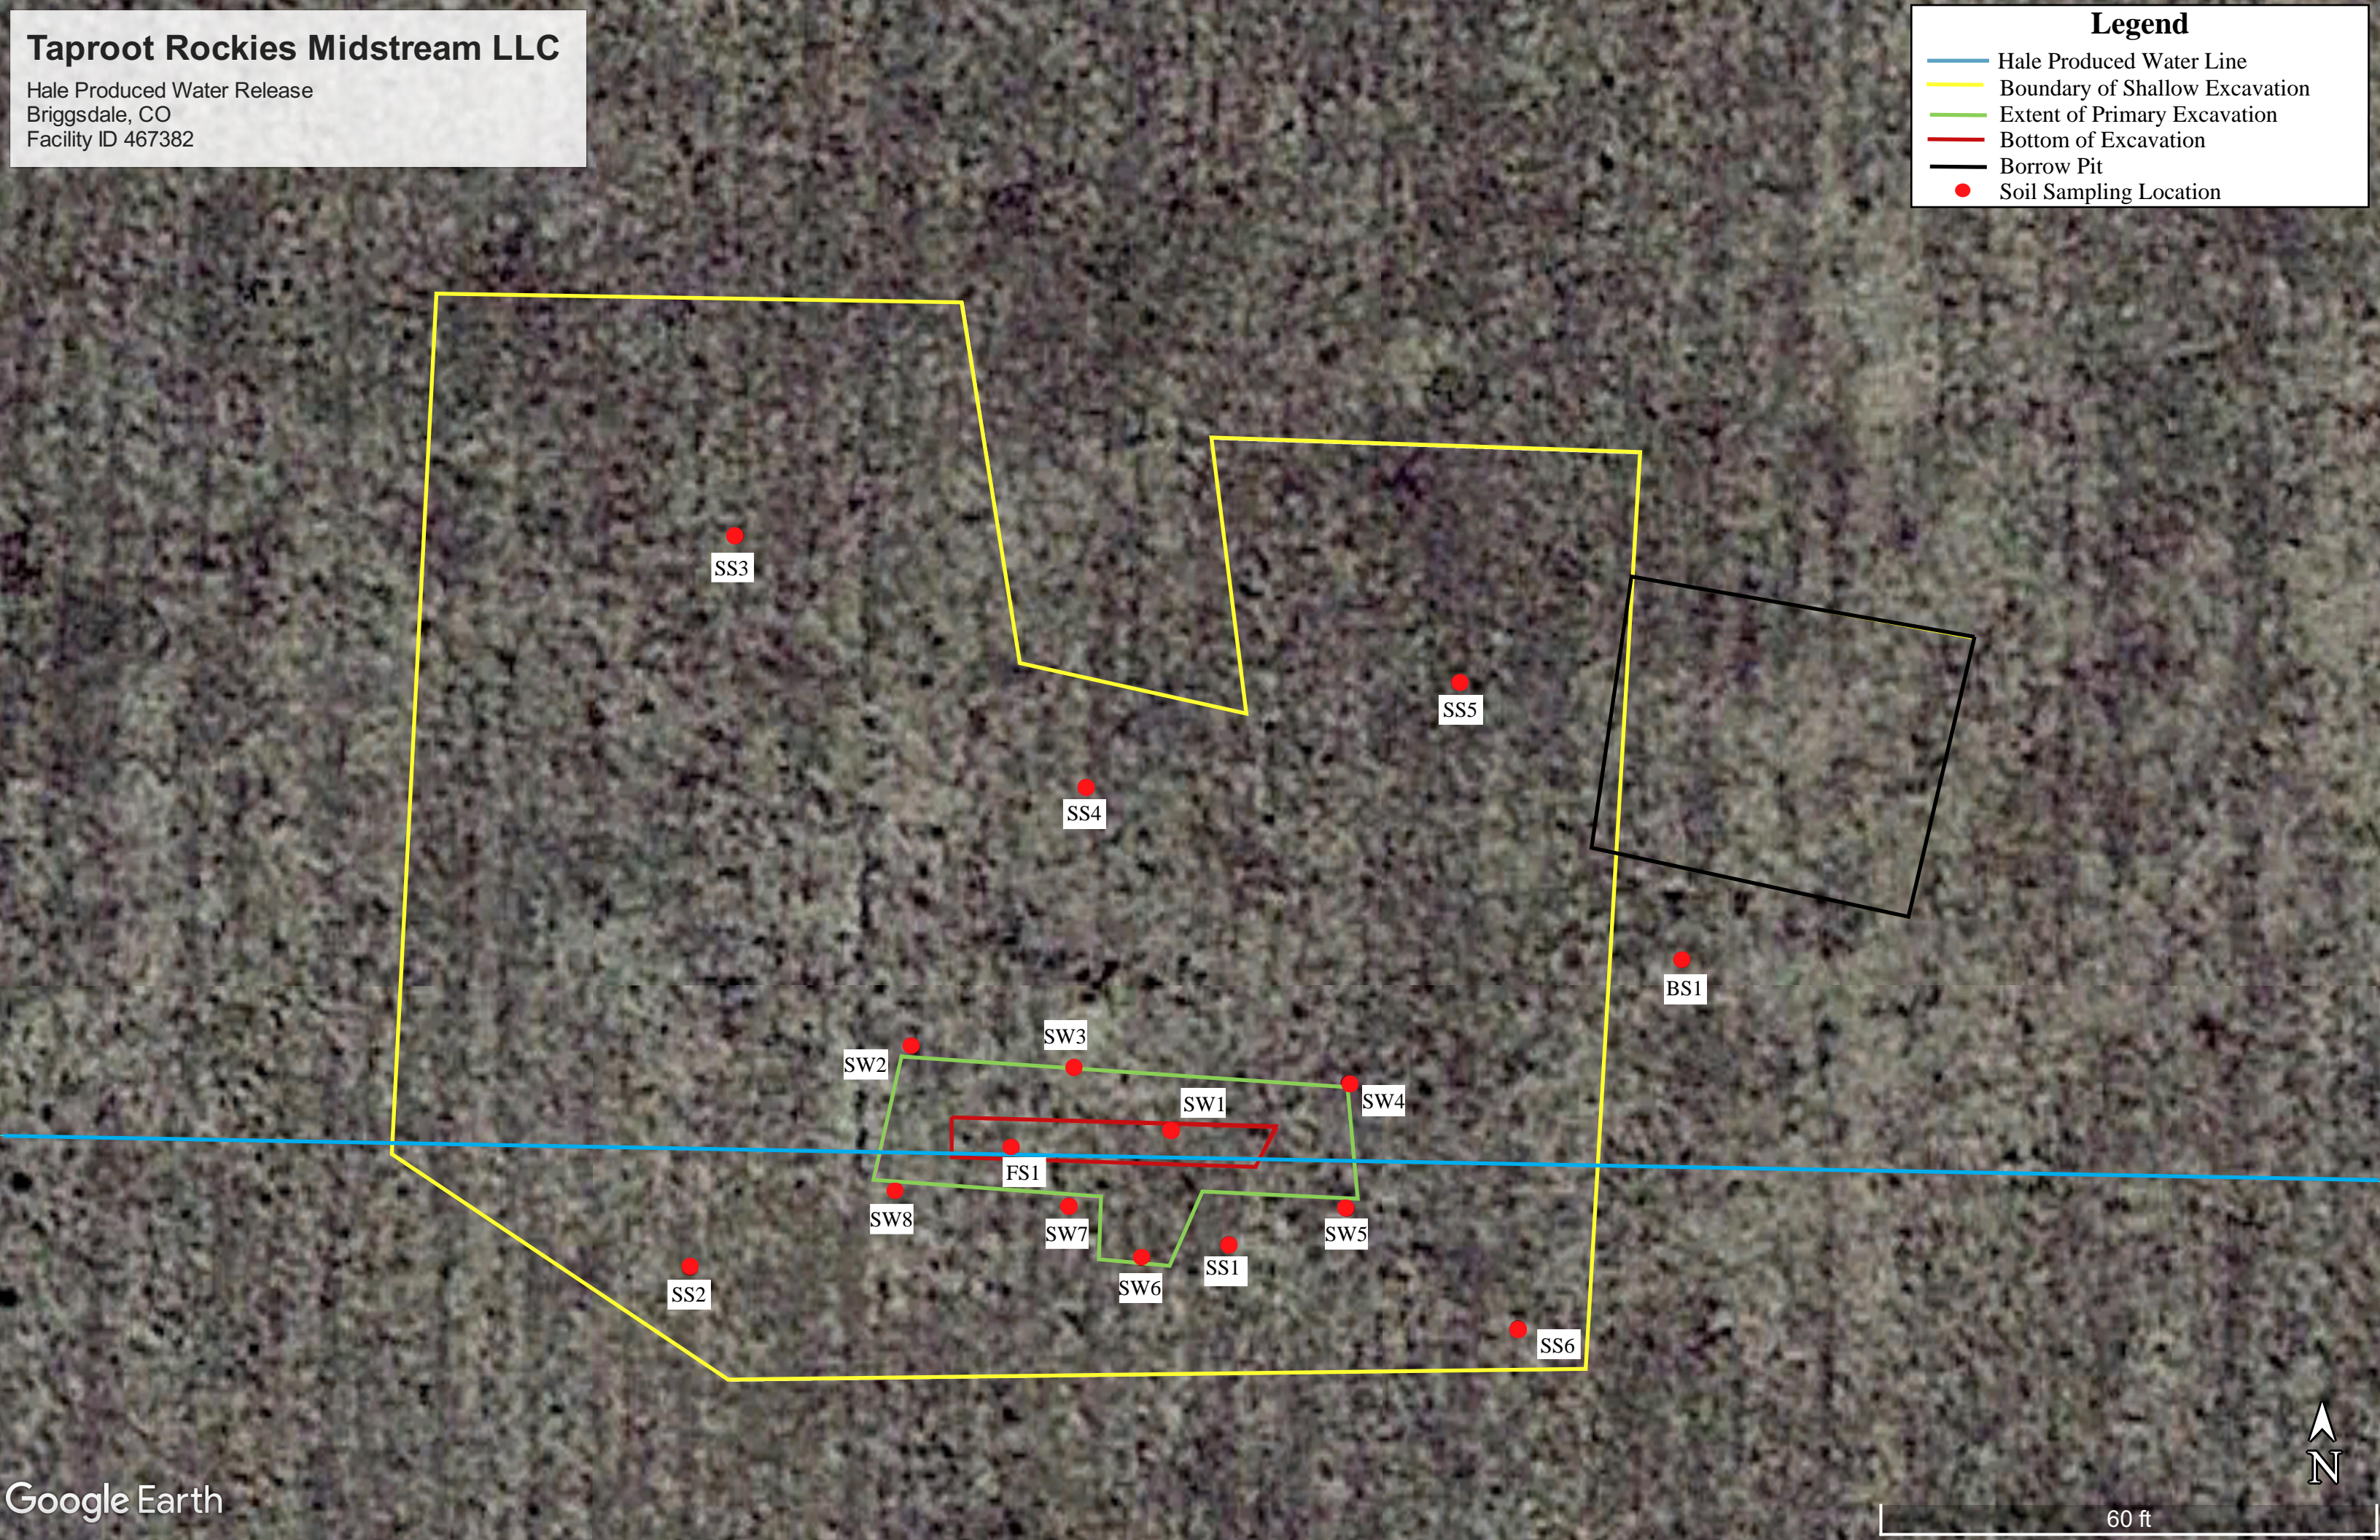

SS3

SS5

SS4

BS1

SW2

SW3

SW1

SW4

FS1

SW8

SW7

SW5

SS2

SW6

SS1

SS6

