


TOP OPERATING COMPANY
TANAKA NO. 1
NE SE SE SEC. 2 T1N R69W
BOULDER COUNTY, COLORADO

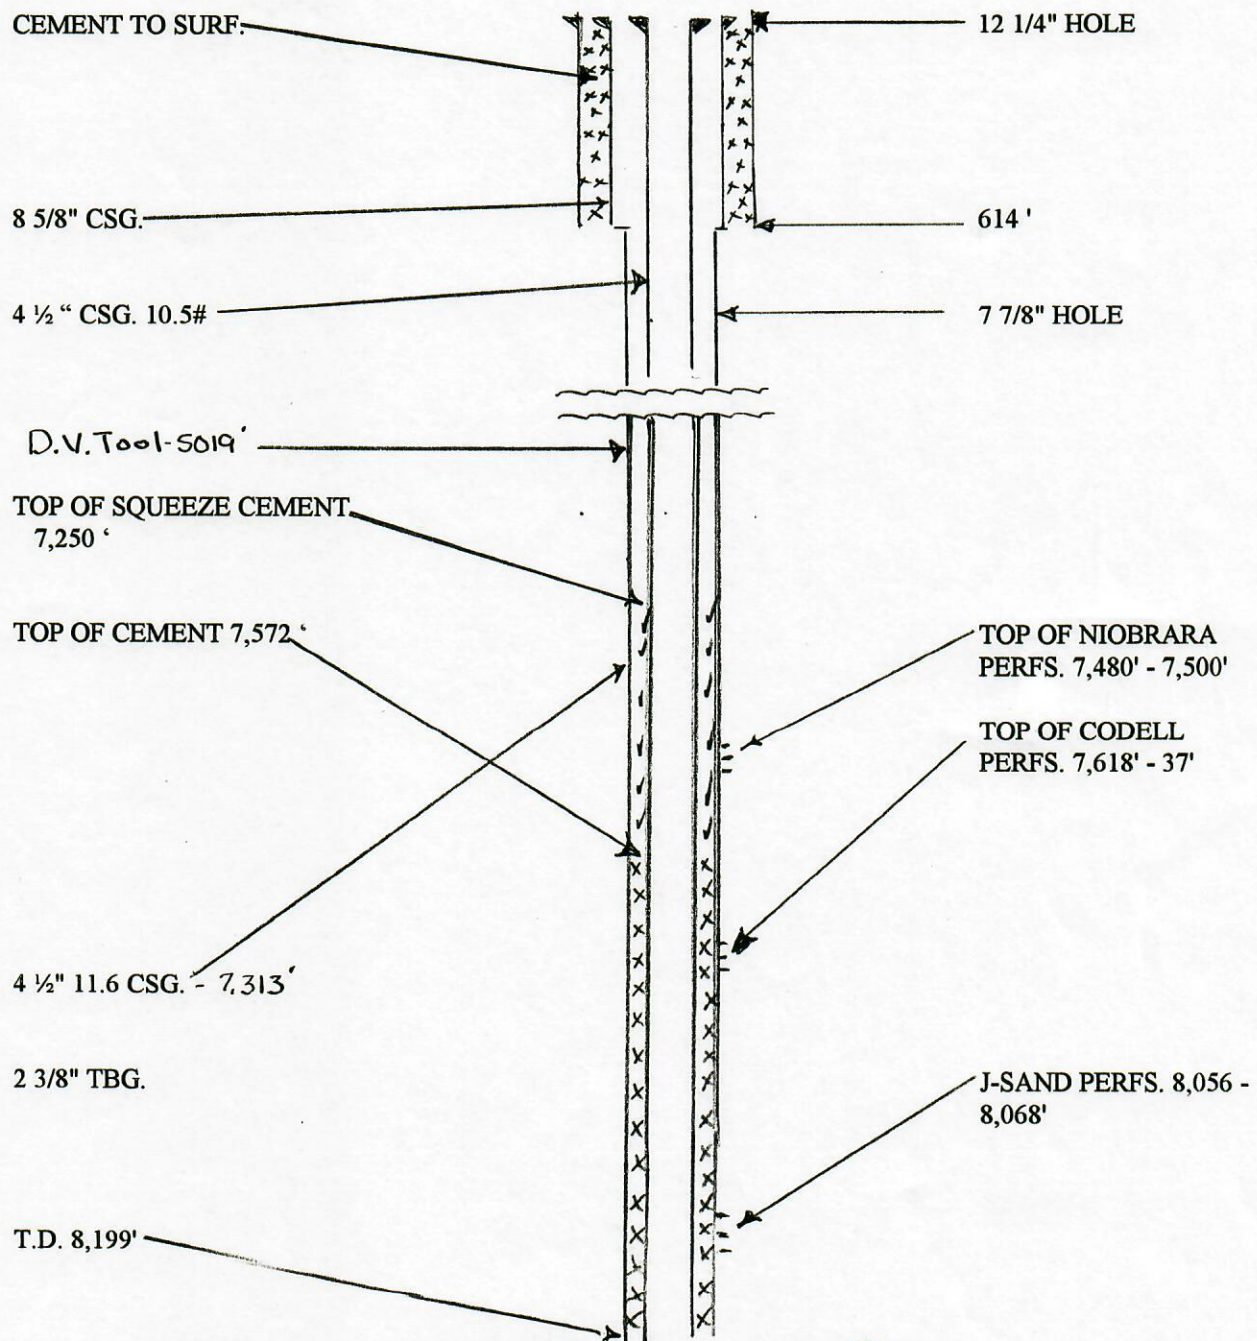

COMPL